

SURVEY & REMONUMENTATION

NOV 16 1998

P.A. 345 ALPENA COUNTY

PEER APPROVED 8/10/98
W.B. Lewis

1998 ALPENA COUNTY REMONUMENTATION CORNER

LAND CORNER RECORDATION CERTIFICATE

Filing Requirement of Act 74, Mich. P.A. 1970

SECTION

Liber 00002 Page 0158

For corners in

Alpema (County)	Located in:	Corner Code #
1. Public Land Survey	T32N R7E	H-7
	T__ R__	Maple Ridge Twp.
	T__ R__	
	T__ R__	
2. Property Controlling in Section	S__ T__ R__	
	S__ T__ R__	
3. Miscellaneous Property in Sec.	S__ T__ R__	
	S__ T__ R__	

STATE OF MICHIGAN
 County of Alpena
 Recorded
 08-20-1998 09:20:15
 Kathy J. Matash
 REGISTER OF DEEDS

Register of Deeds Stamp & File Number

4. Lot No. _____, Recorded Plat _____
 5. Private Claims _____

I, Thomas L. Fabis, in a field survey on Feb. 19, 1998 do hereby state that under requirements of P.A. 74, Michigan P.A. of 1970, the corner points mentioned in lines 1 and 2 above were in conformance with regulations and rules therefore as required in the current manual of survey instructions of the United States Department of the Interior, Bureau of Land Management or by a decree of a Court of Law and /or that the corner points mentioned in lines 3, 4 and 5 above were in conformance with the rules of the Michigan Board of Land Surveyors or by a Decree of a Court of Law; established, re-established, monumented, recovered, found as expressed below:

NOTE: Not more than 2 corners, all in the same town and range, may be recorded on this certificate.

	A	B	C	D	E	F	G	H	I	J	K	L	M
1													
2	6		5		4		3		2		1		
3													
4	7		8		9		10		11		12		
5													
6	18		17		16		15		14		13		
7													
8	19		20		21		22		23		24		
9													
10	30		29		28		27		26		25		
11													
12	31		32		33		34		35		36		
13													

A. Description of original monument and accessories and/or subsequent restoration:

- 1857: G.L.O. Survey Josiah Knauer Set Post & referenced: Hemlock 16 S50E 12, Hemlock 12 N37½W 2½.
- 1889: County Survey Chas. Rice One Wit. tree standing.
- 1897: County Survey Fred Rice Visited corner.
- 1904: County Survey Jos. McNeil Corner in road.
- 1996: Survey Liber 3 Page 17 Earl Lewis Set 1/2" Rerod w/cap in line w/fence & C/L of road and referenced.

B. Description of corner evidence found and/or method applied in restoring or reestablishing corner:

- 1998: No corner monument existing. Found Lewis witnesses and reset corner. Corner falls in centerline of LaComb Rd. (asphalt surface) intersecting with average of 1/4 line fences to the North and South.


The position of this corner is compatible with county and local surveys and is accepted as a careful and faithful perpetuation of the position of the original corner.

C. Description of monument for corner and accessories established to perpetuate locating the position of the corner:

- 1998: Set 1/2" iron rod with 3" dia. brass cap stamped to identify the corner and set a Monument Box around the corner.

Witnesses are:

- North 51.25' Fence Corner
- N20E 51.40' Power Pole
- S15W 134.10' NE Cor. of garage
- S40W 116.50' NE Cor. of house
- N36E 46.63' 4" Cedar

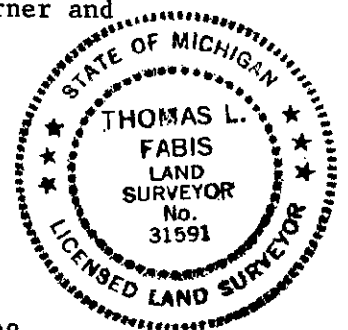

Signed by Thomas L. Fabis
 Surveyor's Michigan License No. 31591

Date August 14, 1998