

**SURVEY &
REMONUMENTATION**

NOV 16 1998

P.A. 345 ALPENA COUNTY
PEER APPROVED 8/10/98 1998 ALPENA COUNTY RE-MONUMENTATION CORNER

SECTION
LAND CORNER RECORDATION CERTIFICATE Liber **000002** Page **0151**
Filing Requirement of Act 74, Mich. P.A. 1970

For corners in

<u>Alpena</u> (County)	Located In:	Corner Code #
1. Public Land Survey	T <u>32NR 7E</u>	<u>1-1</u>
	T ___ R ___	<u>Maple Ridge Twp.</u>
	T ___ R ___	_____
	T ___ R ___	_____
2. Property Controlling in Section	S ___ T ___ R ___	_____
	S ___ T ___ R ___	_____
3. Miscellaneous Property in Sec.	S ___ T ___ R ___	_____
	S ___ T ___ R ___	_____

STATE OF MICHIGAN
County of Alpena
Recorded
08-20-1998 09:19:17
Kathy J. Matash
REGISTER OF DEEDS

Register of Deeds Stamp & File Number

4. Lot No. _____, Recorded Plat _____
5. Private Claims _____

I, Thomas L. Fabis, in a field survey on Feb. 19, 1998 do hereby state that under requirements of P.A. 74, Michigan P.A. of 1970, the corner points mentioned in lines 1 and 2 above were in conformance with regulations and rules therefore as required in the current manual of survey instructions of the United States Department of the Interior, Bureau of Land Management or by a decree of a Court of Law and/or that the corner points mentioned in lines 3, 4 and 5 above were in conformance with the rules of the Michigan Board of Land Surveyors or by a Decree of a Court of Law; established, re-established, monumented, recovered, found as expressed below:


1	A	B	C	D	E	F	G	H	I	J	K	L	M
2		6		5		4		3		2		1	
3													
4		7		8		9		10		11		12	
5													
9													
10		30		29		28		27		26		25	
11													
12		31		32		33		34		35		36	
13													

NOTE: Not more than 2 corners, all in the same town and range, may be recorded on this certificate.

A. Description of original monument and accessories and/or subsequent restoration:
1840: G.L.O. Survey John Hodgson Set post & referenced: Beech 18 N82E 67, Hem 18 N41W 27.
1893: County Survey Fred Rice Visited corner. Stake standing.
1977: L.C.R.C. page 173 Presque Isle Co. Records Ron Bischer 1/2" Rod & referenced.
1990: Survey W.O. 4-1039 Earl Lewis Existing 1/2" Rod & witnessed.

B. Description of corner evidence found and/or method applied in restoring or reestablishing corner:
1998: Found 1/2" iron rod at intersection of road centerlines South and West with fence to the East. This corner position matches with the Earl Lewis survey and is compatible with the 1893 Fred Rice Survey. However, it disagreed with the position using witnesses from Ron Bischer's L.C.R.C. in Presque Isle County Records. Ron Bischer and Porter Survey were both notified of the disagreement and did not object to the acceptance of this 1/2" iron rod as witnessed by Earl Lewis.

C. Description of monument for corner and accessories established to perpetuate locating the position of the corner:
1998: Set 3" dia. brass cap, stamped to identify the corner over the existing 1/2" iron rod.
Reestablished witnesses are:
N35E 34.29' Power Pole w/tag P.S. #22428
S35E 48.73' Anchor Pole w/tag P.S. #22428
S50W 44.21' 6" Twin Apple set tag P.S. #31591
East 30.45' Cor. Fe. Post set tag P.S. #31591

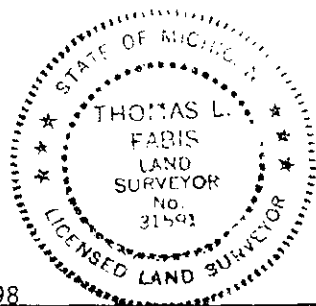

Signed by Thomas L. Fabis
Surveyor's Michigan License No. 31591

Date August 14, 1998