

NOV 16 1998

P.A. 345 ALPENA COUNTY  
PEER APPROVED 8/14/98  
*T.L. Fabis*

1998 ALPENA COUNTY REMONUMENTATION CORNER SECTION

LAND CORNER RECORDATION CERTIFICATE

Filing Requirement of Act 74, Mich. P.A. 1970

Liber 00002 Page 0156

For corners in Alpena (County) Located In: Corner Code #

- 1. Public Land Survey T 32N R 7E L-6  
T \_\_\_\_\_ R \_\_\_\_\_ Maple Ridge Twp.  
T \_\_\_\_\_ R \_\_\_\_\_  
T \_\_\_\_\_ R \_\_\_\_\_
- 2. Property Controlling S \_\_\_\_\_ T \_\_\_\_\_ R \_\_\_\_\_  
in Section S \_\_\_\_\_ T \_\_\_\_\_ R \_\_\_\_\_
- 3. Miscellaneous S \_\_\_\_\_ T \_\_\_\_\_ R \_\_\_\_\_  
Property in Section S \_\_\_\_\_ T \_\_\_\_\_ R \_\_\_\_\_

STATE OF MICHIGAN  
County of Alpena  
Recorded  
08-20-1998 09:19:58  
Kathy J. Matash  
REGISTER OF DEEDS

Register of Deeds Stamp & File Number

- 4. Lot No. \_\_\_\_\_, Recorded Plat \_\_\_\_\_
- 5. Private Claims \_\_\_\_\_

A	B	C	D	E	F	G	H	I	J	K	L	M
2	6	5	4	3	2	1						
3												
4	7	6	9	10	11	12						
5												
6	18	17	16	15	14	13						
7												
8	19	20	21	22	23	24						
9												
10	30	29	28	27	26	25						
11												
12	31	32	33	34	35	36						
13												

I, Thomas L. Fabis, in a field survey on Feb. 19, 19 98, do hereby certify that under requirements of P.A. 74, Michigan P.A. of 1970, the corner points mentioned in lines 1 and 2 above were in conformance with regulations and rules therefore as required in the current manual of survey instructions of the United States Department of the Interior, Bureau of Land Management or by a decree of a Court of Law and/or that the corner points mentioned in lines 3, 4 and 5 above were in conformance with the rules of the Michigan Board of Professional Surveyors or by a Decree of a Court of Law; established, re-established, monumented, re-monumented, recovered, found as expressed below:

NOTE: Not more than 4 corners, all in the same town and range, may be recorded on this certificate.

A. Description of original monument and accessories and/or subsequent restoration:

- 1857:G.L.O. Survey Josiah Knauer Set post & referenced:Hemlock 12 N39W 19, Hemlock 20 S40E 14.
- 1889:County Survey Chas. Rice Visited corner.
- 1891:County Survey William LeRoy Cedar post in road.
- 1897:County Survey Fred Rice Visited corner.
- 1970's:Co. Rd. Comm. Notes Gary St. Charles Found 1" Pipe C/L of Road & witnessed.
- 1971:Survey L.1 P.42 & L.C.R.C. L.1 P.13 James Scott Found 1/2" steel pin & witnessed.
- 1970's:Co. Rd. Comm. Notes Gary St. Charles 1/2" iron & witnessed.
- 1981 & 1989:Surveys W.O. 4-20 & 4-841 Earl Lewis Ex. 1" Rod & referenced.
- 1993:Survey L.2 P.734 & L.C.R.C. L.1 P.258 Thomas Fabis 1/2" Rod in Mon. Box & referenced.
- 1998:Survey W.O. 97361-1 Thomas Fabis Ex. 1/2" iron rod in Mon. Box.


B. Description of corner evidence found and/or method applied in restoring or reestablishing corner:

- 1998: Found 1/2" iron rod in Mon. Box and three existing witnesses with tags P.S. #31591  
S65E 54.23' Tele. Pole  
N85W 32.00' Tele. Pole  
N50W 46.24' Power Pole  
West 43.31' U.S.G.S. Conc. Bench Mark

The position of this corner is compatible with county and local surveys and is accepted as a careful and faithful perpetuation of the position of the original corner.

C. Description of monument for corner and accessories established to perpetuate locating the position of the corner:

- 1998: Set 3" dia. aluminum cap, stamped to identify the corner, over the existing 1/2" iron rod inside the existing Mon. Box.  
Reestablished witnesses are:  
S65E 54.23' Tele. Pole  
N85W 32.00' Tele. Pole  
N50W 46.24' Power Pole  
West 43.31' U.S.G.S. Conc. Bench Mark  
West 33.00' 1/2" iron rod P.S. #31591 property corner

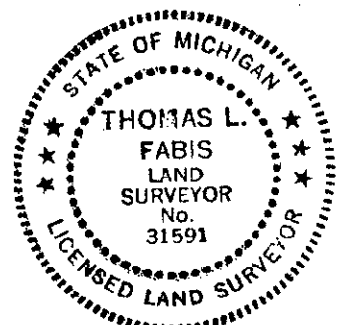

Signed by Thomas L. Fabis

Date August 14, 1998

Surveyor's Michigan License No. 31591