

NOV 16 1998

P.A. 345 ALPENA COUNTY PEER APPROVED 8/14/98 1998 ALPENA COUNTY REMONUMENTATION CORNER

LAND CORNER RECORDATION CERTIFICATE

SECTION 00002 Page 0157

Filing Requirement of Act 74, Mich. P.A. 1970


For corners in Alpena (County) Located in: Corner Code #

- 1. Public Land Survey T 32N R 7E I-7 Maple Ridge Twp
2. Property Controlling in Section S T R
3. Miscellaneous Property in Section S T R

STATE OF MICHIGAN County of Alpena Recorded 08-20-1998 09:20:06 Kathy J. Matash REGISTER OF DEEDS

Register of Deeds Stamp & File Number

- 4. Lot No. Recorded Plat
5. Private Claims

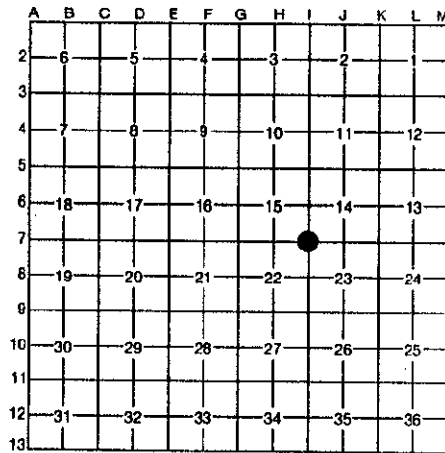

I, Thomas L. Fabis, in a field survey on Feb. 19, 1998, do hereby certify that under requirements of P.A. 74, Michigan P.A. of 1970, the corner points mentioned in lines 1 and 2 above were in conformance with regulations and rules therefore as required in the current manual of survey instructions of the United States Department of the Interior, Bureau of Land Management or by a decree of a Court of Law and/or that the corner points mentioned in lines 3, 4 and 5 above were in conformance with the rules of the Michigan Board of Professional Surveyors or by a Decree of a Court of Law; established, re-established, monumented, re-monumented, recovered, found as expressed below:

NOTE: Not more than 4 corners, all in the same town and range, may be recorded on this certificate.

A. Description of original monument and accessories and/or subsequent restoration:

- 1857: G.L.O. Survey Josiah Knauer set post & referenced: Sugar 14 N50W 19, Sugar 10 S18W 29.
1889 & 1890: County Surveys Chas. Rice & Fred Rice Visits corner.
1904: County Survey Jos. McNeil corner in crossroads.
1971: L.C.R.C. Liber 1 Page 13 James Scott Ex. Steel Pin & referenced.
1971: R.S. Scott Engineering Co. Survey Liber 1 Page 5 Donald Marlatt Visits corner.
1970's: Co. Rd. Comm. Notes Gary St. Charles Iron in Mon. Box & referenced.
1983 & 1987: Surveys W.O. 4-107 & 4-492 Earl Lewis Ex. Mon. Box & referenced.
1993: Hendricks Notes Thomas Fabis 1/2" iron rod in Mon. Box.
1996: Survey Liber 3 Page 17 Earl Lewis ex. 1/2" Rerod in Mon. Box & referenced.
1997: Computer calc's. Lewis & Lewis Makes tie to J-7.


B. Description of corner evidence found and/or method applied in restoring or reestablishing corner:

- 1998: Found 1/2" iron rod in Mon. Box at intersection of Cathro Rd. and LaComb Rd. centerlines (both asphalt surfaces). Also, found three existing witnesses with tags: N32W 75.29' Tele. Pole, S28W 81.14' Tele. Pole, S44E 70.78' Power Pole.

The position of this corner is compatible with county and local surveys and is accepted as a careful and faithful perpetuation of the position of the original corner.

C. Description of monument for corner and accessories established to perpetuate locating the position of the corner:

- 1998: Set 3" dia. aluminum cap, stamped to identify the corner, over the existing 1/2" iron rod inside the existing Mon. Box.
Reestablished witnesses are:
N32W 75.29' Tele. Pole
S28W 81.14' Tele. Pole
S44E 70.78' Power Pole
N38E 91.93 Most S'ly. Cor. of Stone Sign

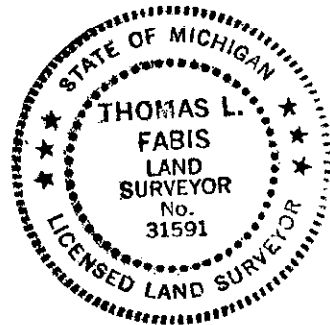

Signed by Thomas L. Fabis

Date August 14, 1998

Surveyor's Michigan License No. 31591