

SURVEY & REMONUMENTATION

NOV 16 1998

P.A. 345 ALPENA COUNTY 1998 ALPENA COUNTY REMONUMENTATION CORNER

PEER APPROVED 8/10/98
D.R. Linn

LAND CORNER RECORDATION CERTIFICATE
Filing Requirement of Act 74, Mich. P.A. 1970

SECTION

00002 Page 0159

For corners in

Alpena (County)	Located in:	Corner Code #
1. Public Land Survey	T 32NR 7E T ___ R ___ T ___ R ___ T ___ R ___	J-7 Maple Ridge Twp. _____ _____
2. Property Controlling in Section	S ___ T ___ R ___ S ___ T ___ R ___	_____ _____
3. Miscellaneous Property In Sec.	S ___ T ___ R ___ S ___ T ___ R ___	_____ _____

STATE OF MICHIGAN
County of Alpena
Recorded
09-10-1998 09:20:22
Kathe J. Matash
REGISTER OF DEEDS

Register of Deeds Stamp & File Number

4. Lot No. _____, Recorded Plat _____
5. Private Claims _____

I, Thomas L. Fabis, in a field survey on Feb. 19, 1998 do hereby state that under requirements of P.A. 74, Michigan P.A. of 1970, the corner points mentioned in lines 1 and 2 above were in conformance with regulations and rules therefore as required in the current manual of survey instructions of the United States Department of the Interior, Bureau of Land Management or by a decree of a Court of Law and /or that the corner points mentioned in lines 3, 4 and 5 above were in conformance with the rules of the Michigan Board of Land Surveyors or by a Decree of a Court of Law; established, re-established, monumented, recovered, found as expressed below:

NOTE: Not more than 2 corners, all in the same town and range, may be recorded on this certificate.

	A	B	C	D	E	F	G	H	I	J	K	L	M
1													
2	6		5		4		3		2		1		
3													
4	7		8		9		10		11		12		
5													
6	18		17		16		15		14		13		
7													
8	19		20		21		22		23		24		
9													
10	30		29		28		27		26		25		
11													
12	31		32		33		34		35		36		
13													

A. Description of original monument and accessories and/or subsequent restoration:

- 1857: G.L.O. Survey Josiah Knauer Set Post & referenced: W. Cedar 11 S23E 18, W. Cedar 10 N13W 12.
- 1890: County Survey Fred Rice Both witness trees standing.
- 1971: L.C.R.C. Liber 1 Page 13 James Scott Ex. Steel Pin & referenced.
- 1970's: Co. Rd. Comm. Notes Gary St. Charles 1/2" iron & witnessed.
- 1993: L.C.R.C. Liber 1 Page 258 Thomas Fabis Exis. 1/2" steel pine & referenced.
- 1993: Hendricks Notes Thomas Fabis 1/2" steel pin.
- 1997: Computer Calc's. Lewis & Lewis Makes ties to east & west.


B. Description of corner evidence found and/or method applied in restoring or reestablishing corner:

- 1998: Found 1/2" iron rod 2 feet North of LaComb Rd. centerline, (asphalt surface). Also, found 3 witnesses tagged P.S. #31591: 5" Willow N20E 46.04', 9" Cedar S20E 59.23', 10" Ash S02E 50.31'.

The position of this corner is compatible with county and local surveys and is accepted as a careful and faithful perpetuation of the position of the original corner.

C. Description of monument for corner and accessories established to perpetuate locating the position of the corner:

- 1998: Set 3" dia. brass cap, stamped to identify the corner over the existing 1/2" iron rod and set a Monument Box around the corner. Reestablished witnesses are:
5" Willow N20E 46.04'
9" Cedar S20E 59.23'
10" Ash S02E 50.31'
7" Willow N52W 68.84'

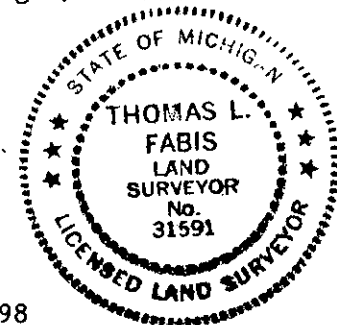

Signed by Thomas L. Fabis
Surveyor's Michigan License No. 31591

Date August 14, 1998