

SURVEY & REMONUMENTATION

NOV 16 1998

P.A. 345 ALPENA COUNTY 1998 ALPENA COUNTY REMONUMENTATION CORNER

PEER APPROVED 8/10/98
D.L.B. [Signature]

LAND CORNER RECORDATION CERTIFICATE
Filing Requirement of Act 74, Mich. P.A. 1970

SECTION

Liber 00002 Page 0160

For corners in

<u>Alpena</u> (County)	Located In:	Corner Code #
1. Public Land Survey	T <u>32NR 7E</u>	<u>K-7</u>
	T ___ R ___	<u>Maple Ridge Twp.</u>
	T ___ R ___	_____
	T ___ R ___	_____
2. Property Controlling in Section	S ___ T ___ R ___	_____
	S ___ T ___ R ___	_____
3. Miscellaneous Property in Sec.	S ___ T ___ R ___	_____
	S ___ T ___ R ___	_____

STATE OF MICHIGAN
County of Alpena
Recorded
08-20-1998 09:20:29
Kathy J. Matash
REGISTER OF DEEDS

Register of Deeds Stamp & File Number

4. Lot No. _____, Recorded Plat _____
5. Private Claims _____

I, Thomas L. Fabis, in a field survey on Feb. 19, 1998 do hereby state that under requirements of P.A. 74, Michigan P.A. of 1970, the corner points mentioned in lines 1 and 2 above were in conformance with regulations and rules therefore as required in the current manual of survey instructions of the United States Department of the Interior, Bureau of Land Management or by a decree of a Court of Law and /or that the corner points mentioned in lines 3, 4 and 5 above were in conformance with the rules of the Michigan Board of Land Surveyors or by a Decree of a Court of Law, established, re-established, monumented, recovered, found as expressed below:

NOTE: Not more than 2 corners, all in the same town and range, may be recorded on this certificate.

	A	B	C	D	E	F	G	H	I	J	K	L	M
1													
2	6		5		4		3		2		1		
3													
4	7		8		9		10		11		12		
5													
6	18		17		16		15		14		13		
7													
8	19		20		21		22		23		24		
9													
10	30		29		28		27		26		25		
11													
12	31		32		33		34		35		36		
13													

A. Description of original monument and accessories and/or subsequent restoration:

- 1857: G.L.O. Survey Josiah Knauer Set post & referenced: Hemlock 22 S31E 27, Beech 13 N3E 42.
- 1892: County Survey Fred Rice Visited corner. Wit. Trees standing.
- 1970's: Co. Rd. Comm. Notes Gary St. Charles Steel Rod & referenced.
- 1971: L.C.R.C. Liber 1 Page 13 James Scott Ex. Steel Pin & referenced.
- 1987: Survey W.O. 4-492 Earl Lewis Ex. 1/2" Rod & referenced.
- 1990: Survey L.2 P.542 L.C.R.C. L.1 P.212 Thomas Fabis Ex. 1/2" iron rod & referenced.
- 1992: Survey W.O. 4-1634 Earl Lewis Ex. 1/2" Rod & referenced.
- 1997: Survey and computer calc's. W.O.04033495 Wayne Lewis Ex. 1/2" rered & referenced.

B. Description of corner evidence found and/or method applied in restoring or reestablishing corner:

- 1998: Found 1/2" iron rod 14 feet East of Schrader Rd. and 5 feet North of LaComb Rd. centerlines. Also found six existing witnesses: N60W 74.40' Fe. Post, N50W 72.61' P. Pole, N20E 57.60' Anchor Pole, N55E 62.38' 5" Balsam, S35E 72.17' Power Pole, and S55W 70.86' 7" Aspen.


The position of this corner is compatible with county and local surveys and is accepted as a careful and faithful perpetuation of the position of the original corner.

C. Description of monument for corner and accessories established to perpetuate locating the position of the corner:

- 1998: Set 3" dia. aluminum cap, stamped to identify the corner, over the existing 1/2" iron rod.

Reestablished witnesses are:

- N60W 74.40' Fe. Post
- N50W 72.61' P. Pole
- N20E 57.60' Anchor Pole
- N55E 62.38' 5" Balsam
- S35E 72.17' Power Pole
- S55W 70.86' 7" Aspen

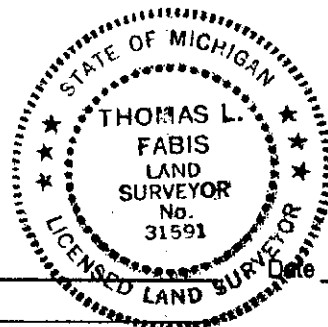

Signed by Thomas L. Fabis

August 14, 1998

Surveyor's Michigan License No. 31591