

**SURVEY &  
REMONUMENTATION**

NOV 16 1998

P.A. 345 ALPENA COUNTY  
PEER APPROVED 8/10/98  
*D.J.B. L.A.H.*

1998 ALPENA COUNTY REMONUMENTATION CORNER SECTION  
**LAND CORNER RECORDATION CERTIFICATE**  
Filing Requirement of Act 74, Mich. P.A. 1970

Liber 00002 Page 0161

For corners in

<u>Alpena</u> (County)	Located In:	Corner Code #
1. Public Land Survey	T32N R7E T___ R___ T___ R___ T___ R___	L-7 Maple Ridge Twp.
2. Property Controlling in Section	S___ T___ R___ S___ T___ R___	_____
3. Miscellaneous Property in Sec.	S___ T___ R___ S___ T___ R___	_____
4. Lot No. _____, Recorded Plat _____		
5. Private Claims _____		

STATE OF MICHIGAN  
County of Alpena  
Recorded  
08-20-1998 09:20:37  
Kathy J. Matash  
REGISTER OF DEEDS

Register of Deeds Stamp & File Number

I, Thomas L. Fabis, in a field survey on Feb. 19, 1998 do hereby state that under requirements of P.A. 74, Michigan P.A. of 1970, the corner points mentioned in lines 1 and 2 above were in conformance with regulations and rules therefore as required in the current manual of survey instructions of the United States Department of the Interior, Bureau of Land Management or by a decree of a Court of Law and /or that the corner points mentioned in lines 3, 4 and 5 above were in conformance with the rules of the Michigan Board of Land Surveyors or by a Decree of a Court of Law; established, re-established, monumented, recovered, found as expressed below:

NOTE: Not more than 2 corners, all in the same town and range, may be recorded on this certificate.


A	B	C	D	E	F	G	H	I	J	K	L	M
1												
2	6		5		4		3		2		1	
3												
4	7		8		9		10		11		12	
5												
6	18		17		16		15		14		13	
7												
8	19		20		21		22		23		24	
9												
10	30		29		28		27		26		25	
11												
12	31		32		33		34		35		36	
13												

- A. Description of original monument and accessories and/or subsequent restoration:
- 1857: G.L.O. Survey Josiah Knauer Set post & referenced: Hemlock 15 S13E 29, Hemlock 10 N8W 42.
  - 1990: Hendricks Survey L.2 P.542 and L.C.R.C. L.1 P.212 Thomas Fabis Ex. 1 1/2" pipe & referenced.
  - 1992: Survey W.O. 4-1634 Earl Lewis Existing pipe & referenced.
  - 1996: R.S.Scott Associates Survey W.O. 4-9627 David Guthrie Exist. 2" Pipe.
  - 1997: R.S.Scott Associates Survey W.O. 4-9788 David Guthrie Exis. 2" Pipe.

- B. Description of corner evidence found and/or method applied in restoring or reestablishing corner:
- 1998: Found 1 1/2" iron pipe 3.5 feet North of LaComb Rd. centerline intersecting 1/4 line fence to the North and Brushed survey line South. Also, found the following witnesses: 6" Cedar S56W 62.72', 6" Maple N50E 42.72', 5" Maple S40E 56.18', and 1/2" prop. iron due South 33.45'

The position of this corner is compatible with county and local surveys and is accepted as a careful and faithful perpetuation of the position of the original corner.

- C. Description of monument for corner and accessories established to perpetuate locating the position of the corner:
- 1998: Replaced existing pipe with 1/2" iron rod with 3" dia. aluminum cap, stamped to identify the corner.  
Reestablished witnesses are:  
6" Cedar S56W 62.72'  
6" Maple N50E 42.72'  
5" Maple S40E 56.18'  
1/2" prop. iron due South 33.45'

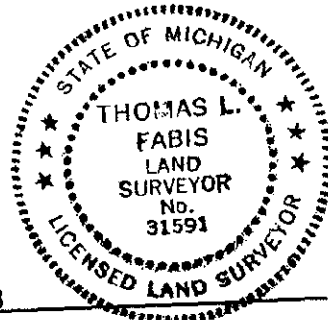

Signed by Thomas L. Fabis  
Surveyor's Michigan License No. 31591

Date August 14, 1998