

DEC 1 0 1993

LIBER 1 PAGE 261 007560

RECORDED ALPENA COUNTY MI.

1993 Alpena County Remonumentation Corner.

COMMISSION

LAND CORNER RECORDATION CERTIFICATE
Filing Requirement of Act 74, Mich. P.A. 1970

DEC 1 3 16 PM '93

REGISTER OF DEEDS

For corners in

Alpena (County)

Located In:

Corner Code -##

- 1. Public Land Survey T 32N R 8E A-6 (W 1/2, 18) (Alpena Twp.)
2. Property Controlling in Section S T R
3. Miscellaneous Property in Sec. S T R

Register of Deeds Stamp & File Number

- 4. Lot No. Recorded Plat
5. Private Claims

Grid table with columns A-M and rows 2-13. Cell (6, A) contains a dot.

I, Thomas L. Fabis, in a field survey on August 19, 1993, do hereby certify that under requirements of P.A. 74, Michigan P.A. of 1970, the corner points mentioned in lines 1 and 2 above were in conformance with regulations and rules therefore as required in the current manual of survey instructions of the United States Department of the Interior, Bureau of Land Management or by a decree of a Court of Law and/or that the corner points mentioned in lines 3, 4 and 5 above were in conformance with the rules of the Michigan Board of Land Surveyors or by a Decree of a Court of Law; established, re-established, monumented, re-monumented, recovered, found as expressed below:

NOTE: Not more than 4 corners, all in the same town and range, may be recorded on this certificate.

A. Description of original monument and accessories and/or subsequent restoration:

- 1855: G.L.O. Resurvey by Josiah Knauer - set post (Beech 10 S46W 22, Beech 12 N35W 15).
1889: County Survey by Chas. Rice - Found old stake.
1893: County Survey by Fred A. Rice - Found old stake and one witness stump, placed deposit of crockery at stake.
1904: County Survey by Jos. W. McNeil - Found old stake in road bed, dug up old and set new cedar stake 4" square flush with road bed, deposited pieces of earthen ware around same.


B. Description of corner evidence found and/or method applied in restoring or reestablishing corner:

- 1993: Found P.K. nail in center of gravel road bed (Haken Road) opposite an old E-W. 1/4 line fence on East side of road and is accepted as the best available evidence of the position of the original corner. The position of this corner is compatible with the old County Surveys.

C. Description of monument for corner and accessories established to perpetuate locating the position of the corner:

- 1993: Removed existing corner material and set 1/2" iron rod with 3" aluminum cap stamped to identify the corner. Reestablished witnesses are:

- Set tag #31591 in 5" Elm - S87°E - 30.62'
Set tag #31591 in 14" Maple - S65°E - 65.68'
Set tag #31591 in 3" Cedar - S82°W - 34.03'
Set tag #31591 in 14" Maple - S50°W - 37.08'

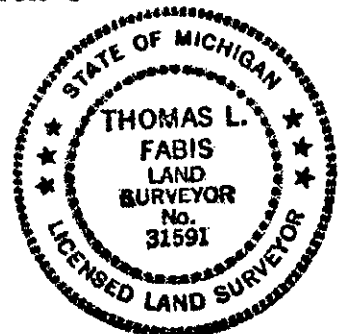

Signed by Thomas L. Fabis

Date November 22, 1993

Surveyor's Michigan License No. 31591