

DEC 10 1993

LIBER 1 PAGE 263 007562

RECORDED ALPENA COUNTY MI.

1993 Alpena County Remonumentation Corner.

LAND CORNER RECORDATION CERTIFICATE
Filing Requirement of Act 74, Mich. P.A. 1970

DEC 1 3 16 PM '93

REGISTER OF DEEDS

For corners in

Alpena (County) Located In: Corner Code =#

- 1. Public Land Survey T 32N R 8E A-7 (SW, 18) (Alpena Twp.)
2. Property Controlling in Section S T R
3. Miscellaneous Property in Sec. S T R

Register of Deeds Stamp & File Number

- 4. Lot No. Recorded Plat
5. Private Claims

Grid table with columns A-M and rows 1-13. A dot is marked at row 7, column A.

I, Thomas L. Fabis, in a field survey on August 19, 1993, do hereby certify that under requirements of P.A. 74, Michigan P.A. of 1970, the corner points mentioned in lines 1 and 2 above were in conformance with regulations and rules therefore as required in the current manual of survey instructions of the United States Department of the Interior, Bureau of Land Management or by a decree of a Court of Law and/or that the corner points mentioned in lines 3, 4 and 5 above were in conformance with the rules of the Michigan Board of Land Surveyors or by a Decree of a Court of Law; established, re-established, monumented, re-monumented, recovered, found as expressed below:


NOTE: Not more than 4 corners, all in the same town and range, may be recorded on this certificate.

- A. Description of original monument and accessories and/or subsequent restoration:
1855: G.L.O. Resurvey by Josiah Knauer - set post (Beech 12 S33E 29, Beech 7 N8E 17).
1893: County Survey by Fred A. Rice - found G.L.O. corner and witness stumps. Placed deposit of crockery at stake.
1971: L.C.R.C. Liber 1 Page 11 by James L. Scott - Found 1" pipe (S45°E-48.5' - P.P., S30°W - 93.75' - 6" Apple)

- B. Description of corner evidence found and/or method applied in restoring or reestablishing corner:
1993: Found 1/2" iron rod at the intersection of Haken Road and Lacombe Road, set and used by other land surveyors. This corner is accepted as a careful and faithful perpetuation of the position of the original corner. Also, found one witness (S45°E - 48.5' - P.P.) as per L.C.R.C. Liber 1 Page 11. The position of this corner is compatible with the Old County Surveys.

- C. Description of monument for corner and accessories established to perpetuate locating the position of the corner:
1993: Removed existing corner material and set 1/2" iron rod with 3" aluminum cap, stamped to identify the corner. Reestablished witnesses are:

- Set tag #31591 in 7" Apple - S25°W - 94.40'
Set tag #31591 in 4" Elm - N75°E - 131.18'
Exis. tag in 7" apple - S55°W - 90.18'
Exis. tag in P. Pole - S45°E - 48.72'

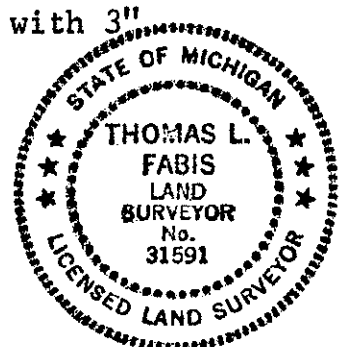

Signed by Thomas L. Fabis Date November 22, 1993
Surveyor's Michigan License No. 31591