

DEC 1 0 1993

LIBER

1 PAGE 267 007566

RECORDED ALPENA COUNTY MI.

1993 Alpena County Remonumentation Corner.

DEC 1 3 16 PM '93

LAND CORNER RECORDATION CERTIFICATE Filing Requirement of Act 74, Mich. P.A. 1970

REGISTER OF DEEDS

For corners in

Alpena

(County)

Located In:

Corner Code --#

- 1. Public Land Survey T 32N R 8E B-5 (N 1/2, 18) (Alpena Twp.)
2. Property Controlling in Section S T R
3. Miscellaneous Property in Sec. S T R

Register of Deeds Stamp & File Number

- 4. Lot No. Recorded Plat
5. Private Claims

Grid table with columns A-M and rows 2-13. A dot is marked at row 5, column B.

I, Thomas L. Fabis, in a field survey on August 19, 1993, do hereby certify that under requirements of P.A. 74, Michigan P.A. of 1970, the corner points mentioned in lines 1 and 2 above were in conformance with regulations and rules therefore as required in the current manual of survey instructions of the United States Department of the Interior, Bureau of Land Management or by a decree of a Court of Law and/or that the corner points mentioned in lines 3, 4 and 5 above were in conformance with the rules of the Michigan Board of Land Surveyors or by a Decree of a Court of Law; established, re-established, monumented, re-monumented, recovered, found as expressed below:


NOTE: Not more than 4 corners, all in the same town and range, may be recorded on this certificate.

A. Description of original monument and accessories and/or subsequent restoration: 1855: G.L.O. Resurvey by Josiah Knauer - Set post (Sugar 10 N28W 6, Hemlock 11 S34E 29).

B. Description of corner evidence found and/or method applied in restoring or reestablishing corner: 1993: Set 1/2" iron rod on straight line between N.W. corner and N.E. corner of Section 18 at intersection with the N-S 1/2 line established by extension of line from the S 1/2 corner thru the center of section using County Survey Notes by Jos. W. McNeil in 1904 for reference. The position of this corner harmonizes with the location of the existing East N-S 1/8 line fence in section 18. It is located in the center of a E-W two track 9.5 feet north of new E-W fence.

C. Description of monument for corner and accessories established to perpetuate locating the position of the corner: 1993: Set 1/2" iron rod with 3" aluminum cap, stamped to identify the corner.

- Reestablished witnesses are: Set tag #31591 in 14" Maple - N10°W - 27.64' Set tag #31591 in 6" iron wood - N50°E - 28.94' Set tag #31591 in 4" Ash - S10°E - 21.04' Set tag #31591 in 4" ironwood - S70°W - 41.48'

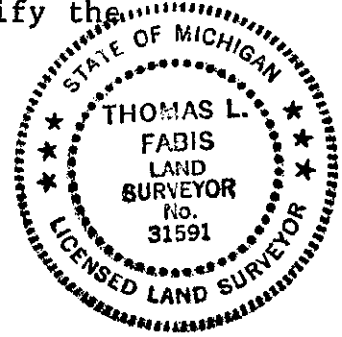

Signed by Thomas L. Fabis

Date November 22, 1993

Surveyor's Michigan License No. 31591