

DEC 10 1993

LIBER

1 PAGE 262 07561

RECORDED ALPENA COUNTY MI.

1993 Alpena County Remonumentation Corner: COMMISSION

LAND CORNER RECORDATION CERTIFICATE Filing Requirement of Act 74, Mich. P.A. 1970

DEC 1 3 16 PM '93

REGISTER OF DEEDS

For corners in

Alpena (County)

Located In:

Corner Code: #

- 1. Public Land Survey T 32N R 8E C-5 (NE, 18) (Alpena Twp.)
2. Property Controlling in Section S T R
3. Miscellaneous Property in Sec. S T R

- 4. Lot No. Recorded Plat
5. Private Claims

I, Thomas L. Fabis, in a field survey on August 19, 1993, do hereby certify that under requirements of P.A. 74, Michigan P.A. of 1970, the corner points mentioned in lines 1 and 2 above were in conformance with regulations and rules therefore as required in the current manual of survey instructions of the United States Department of the Interior, Bureau of Land Management or by a decree of a Court of Law and/or that the corner points mentioned in lines 3, 4 and 5 above were in conformance with the rules of the Michigan Board of Land Surveyors or by a Decree of a Court of Law; established, re-established, monumented, re-monumented, recovered, found as expressed below:

NOTE: Not more than 4 corners, all in the same town and range, may be recorded on this certificate.

A. Description of original monument and accessories and/or subsequent restoration:

- 1855: G.L.O. Resurvey by Josiah Knauer - Set post (Y. Birch 10 N. 53 1/4 E 39, Cedar 11 S 35 1/4 W 26)
1907: County survey by Jos. W. McNeil - Found cedar stake previously set by Fred A. Rice.
1987: Recorded survey Liber 2 Pages 422 & 423 by David B. Guthrie - Found 1/2" iron rod and established 3 witnesses (N05°W - 5" Spruce - 30.93 feet, S50°W - Fence Post - 36.51 feet, East - 7" Aspen - 42.32 feet)


B. Description of corner evidence found and/or method applied in restoring or reestablishing corner:

- 1993: Found 1/2" iron rod and 3 witnesses as per recorded survey by David B. Guthrie and is accepted as a careful and faithful perpetuation of the position of the original corner. This corner is used by other land surveyors for local surveys.

C. Description of monument for corner and accessories established to perpetuate locating the position of the corner:

- 1993: Removed existing corner material and set 1/2" iron rod with 3" aluminum cap stamped to identify the corner. Reestablished witnesses are: Set tag #31591 in 8" Aspen - N70°E - 43.07', Set tag #31591 in 5" Aspen - S60°E - 58.81', Set tag #31591 in 5" Spruce - N08°W - 30.96', Set tag #31591 in 2" Cedar - S52°W - 66.05'

Grid table with columns A-M and rows 1-13. A dot is marked at row 5, column C.

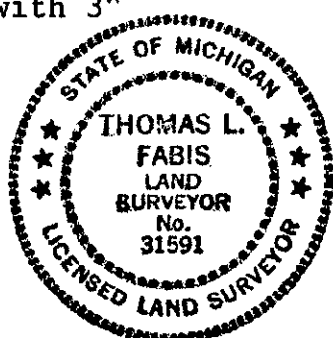

Signed by Thomas L. Fabis, Surveyor's Michigan License No. 31591

November 22, 1993