

DEC 10 1993

LIBER 1 PAGE 268 007567

RECORDED ALPENA COUNTY MI.

1993 Alpena County Remonumentation Corner.

LAND CORNER RECORDATION CERTIFICATE
Filing Requirement of Act 74, Mich. P.A. 1970

DEC 1 3 16 PM '93

REGISTER OF DEEDS

corners in

Table with columns: Located In, Corner Code, Public Land Survey, Property Controlling in Section, Miscellaneous, Property in Sec.

Register of Deeds Stamp & File Number

Lot No. , Recorded Plat
Private Claims

Grid table with columns A-M and rows 2-13, containing numbers 1-36.


Thomas L. Fabis in a field survey on August 19, 1993
hereby certify that under requirements of P.A. 74, Michigan P.A. of 1970, the corner points mentioned in lines 1 and 2 above were in conformance with regulations and rules...

NOTE: Not more than 4 corners, all in the same town and range, may be recorded on this certificate.

- Description of original monument and accessories and/or subsequent restoration:
1855: G.L.O. Resurvey by Josiah Knauer - Set post (Sugar 7 S59E 16, Beech 7 N47W 9).
1898: County survey by Fred A. Rice - Found corner well established.
1908: County survey by Jos. W. McNeil - Found old post and one N.B.T. stump and set new cedar stake.
1971: L.C.R.C. Liber 1 Page 11 by James L. Scott - Witnessed existing corner.
1976: Recorded survey Liber 1 Page 298 by David B. Guthrie - found 1/2" iron and witnessed.
1983: Unrecorded survey W.O. 004-83 by Gary St. Charles - found 1/2" iron and witnessed.

Description of corner evidence found and/or method applied in restoring or reestablishing corner:
1993: Found 1/2" iron rod and 2 witnesses (S28°W - Power Pole - 35.52', N59°E - 24" Elm Stump - 53.61') as per unrecorded survey by St. Charles and is accepted as a careful and faithful perpetuation of the position of the original corner.

Description of monument for corner and accessories established to perpetuate locating the position of the corner:
1993: Removed existing corner material and set 1/2" iron rod with 3" aluminum cap, stamped to identify the corner.
Reestablished witnesses are:
Exis. tag in P. Pole - S28°W - 35.53'
Exis. tag in Elm Stump - N46°E - 53.69'
Set tag #31591 in 7" Maple - S15°E - 49.87'
Set tag #31591 in 10" Ash - S20°W - 55.75'
Set tag #31591 in 8" Maple - N45°E - 62.32'

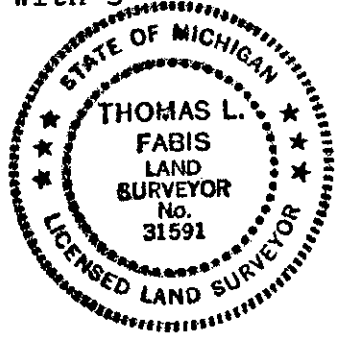

Signed by Thomas L. Fabis Date November 22, 1993
Surveyor's Michigan License No. 31591