

DEC 10 1993

LIBER

1 PAGE 257

007129

1993 ALPENA COUNTY Remonumentation Corner

LAND CORNER RECORDATION CERTIFICATE
Filing Requirement of Act 74, Mich. P.A. 1970

RECORDED ALPENA COUNTY MI.

For corners in

Alpena

(County)

Located In:

Corner Code #

- 1. Public Land Survey T 32N R 8E C-9
2. Property Controlling in Section S T R
3. Miscellaneous Property in Sec. S T R

Nov 12 12 55 PM '93

REGISTER OF DEEDS

Register of Deeds Stamp & File Number

- 4. Lot No. Recorded Plat
5. Private Claims

Grid table with columns A-M and rows 2-13. A dot is marked at row 9, column C.

David B. Guthrie a field survey on July 12, 1993, do hereby certify that under requirements of P.A. 74, Michigan P.A. of 1970, the corner points mentioned in lines 1 and 2 above were in conformance with regulations and rules therefore as required in the current manual of survey instructions of the United States Department of the Interior, Bureau of Land Management or by a decree of a Court of Law and/or that the corner points mentioned in lines 3, 4 and 5 above were in conformance with the rules of the Michigan Board of Land Surveyors or by a Decree of a Court of Law; established, re-established, monumented, re-monumented, recovered, found as expressed below:

NOTE: Not more than 4 corners, all in the same town and range, may be recorded on this certificate.

A. Description of original monument and accessories and/or subsequent restoration:

- 1855: G.L.O Re-survey by Josiah Knauer - set post and referenced: Birch 8 - N47°E - 49 / W.Birch 6 - S50°E - 62.
1888: County survey by Fred A. Rice - Found G.L.O Corner
1971: Survey by James L. Scott - Found 1" iron Pipe.
1978: Survey by David B. Guthrie - Found 1" iron pipe and referenced: S45°W - Utility Pole - 56.30 feet / N75°W - Utility Pole - 52.1- feet / N45°W - 8" Ash - 58.22 feet.
1972: Survey by Edward LaCross - Found Iron
1992: Survey by Porter's Survey - Found Iron Pipe

B. Description of corner evidence found and/or method applied in restoring or reestablishing corner:


1993: Found 1" iron pipe which has been used for local surveys. The location of this corner is compatible with former County Surveys which were completed approximately 30 years after the G.L.O Survey. This corner lies in the road intersection.

C. Description of monument for corner and accessories established to perpetuate locating the position of the corner:

- 1993: Set 1/2" x 24" iron Rod with 3" aluminum cap stamped to identify the corner. Referenced:
N35°E - 6" Aspen - 27.23 feet
S26°E - 4" Spruce - 69.43 feet
S56°W - Utility Pole - 56.74 feet
N15°W - 8" Aspen - 22.18 feet

Signed by [Signature]

Date 11/12

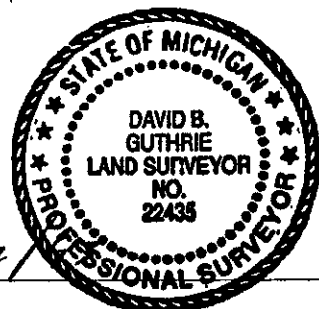

Surveyor's Michigan License No. 22435