

LAND CORNER RECORDATION CERTIFICATE
Filing Requirement of Act 74, Mich. P.A. 1970

Dec 16 10 19 AM '93

For corners in

Alpena (County)

Located In:


Corner Code #

- 1. Public Land Survey T 32N R 8E F-9
2. Property Controlling in Section S T R
3. Miscellaneous Property in Sec. S T R

REGISTER OF DEEDS

Register of Deeds Stamp & File Number

- 4. Lot No. Recorded Plat
5. Private Claims

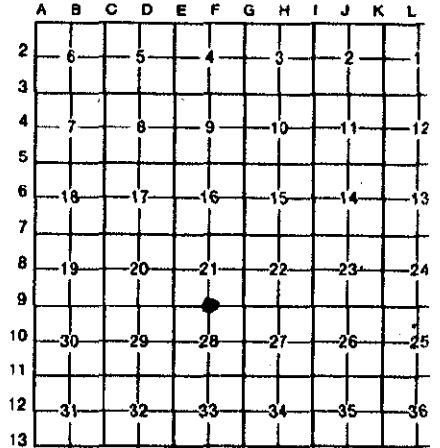

Duane R. MacNeill, in a field survey on July 20, 1993, do hereby certify that under requirements of P.A. 74, Michigan P.A. of 1970, the corner points mentioned in lines 1 and 2 above were in conformance with regulations and rules therefor as required in the current manual of survey instructions of the United States Department of the Interior, Bureau of Land Management or by a decree of a Court of Law and/or that the corner points mentioned in lines 3, 4 and 5 above were in conformance with the rules of the Michigan Board of Land Surveyors or by a Decree of a Court of Law; established, re-established, monumented, re-monumented, recovered, found as expressed below:

NOTE: Not more than 4 corners, all in the same town and range, may be recorded on this certificate.

A. Description of original monument and accessories and/or subsequent restoration:

1855 - Cedar Post

1887 - County Surveyor Rice found original bearing trees

1989 - 1/2" Rerod found by Gary St. Charles as recorded. No original evidence found.

Witnesses:

Cedar 8 S 5 1/2 W 16

Do 11 N 27 E 7

Witnesses:

N 73° E 99.63' Power Pole
N 45° W 85.57' 6" Ash
S 51° W 56.58' Power Pole

B. Description of corner evidence found and/or method applied in restoring or reestablishing corner:

Found above 1/2" rerod and witnesses during remonumentation field work
6" Ash witness was not found.

C. Description of monument for corner and accessories established to perpetuate locating the position of the corner:

Appropriately stamped Alpena County Remonumentation Aluminum Cap secured to existing rerod approx. 8" below road surface.

Witnesses:

N 78° E 99.64' Power Pole Fd.
S 46° W 56.57' Power Pole Fd.
N 10° E 51.62' 5" Spruce Fd. Tag #31591
S 28° E 53.64' 4" Apple Set

Witnesses were freshened as necessary, nails replaced with duplex nails bearing a brass washer stamped License #19237

Signed by

[Signature]

Date December 6, 1993

Surveyor's Michigan License No. 19237

