

LIBER

1 PAGE 284

1993 ALPENA COUNTY REMONUMENTATION CORNER

RECORDED ALPENA COUNTY MI.

LAND CORNER RECORDATION CERTIFICATE Filing Requirement of Act 74, Mich. P.A. 1970

Dec 16 10 19 AM '93

Register of Deeds REGISTER OF DEEDS

Register of Deeds Stamp & File Number

For corners in

Alpena (County)

Located In: Corner Code #

- 1. Public Land Survey T 32N R 8E H - 7
2. Property Controlling in Section S T R
3. Miscellaneous Property in Sec. S T R

- 4. Lot No. , Recorded Plat
5. Private Claims

Grid table with columns A-K and rows 2-13. A dot is present at row 7, column H.

I, Duane R. MacNeill, in a field survey on July 20, 1993, do hereby certify that under requirements of P.A. 74, Michigan P.A. of 1970, the corner points mentioned in lines 1 and 2 above were in conformance with regulations and rules therefore as required in the current manual of survey instructions of the United States Department of the Interior, Bureau of Land Management or by a decree of a Court of Law and/or that the corner points mentioned in lines 3, 4 and 5 above were in conformance with the rules of the Michigan Board of Land Surveyors or by a Decree of a Court of Law, established, re-established, monumented, re-monumented, recovered, found as expressed below.

NOTE: Not more than 4 corners, all in the same town and range, may be recorded on this certificate.

A. Description of original monument and accessories and/or subsequent restoration:

1855 - Cedar Post No subsequent work by Alpena County Surveyors

Witnesses:

Hemlock 9 N 74° E 14
Do 12 S 41° W 24

B. Description of corner evidence found and/or method applied in restoring or reestablishing corner:

1992 - Corner recorded by Tom Fabis #31591
- Found 1/2" Rod 9' South of Centerline of Lacombe Road

Witnesses:

S 40° W 121.54' Power Pole
S 19° E 104.60' 3" Ash
N 85° E 153.03' Power Pole
N 48° W 85.45' 3" Ash

During Remonumentation field work it was discovered that a monument box had been placed around the 1/2 " rod.

C. Description of monument for corner and accessories established to perpetuate locating the position of the corner:


Monument box was opened and appropriately stamped Alpena County Remonumentation. Aluminum Cap was secured to existing Rerod.

Witnesses:

S 82° E 152.91' Light Pole Fd.
S 22° W 121.40' Power Pole Fd.
N 66° E 124.00' USCGS Sat Pos. Marker
N 44° W 78.98' 4" Ash Set

Witnesses were freshened as necessary nails were replaced with duplex nails bearing a brass washer stamped with License #19237

Signed by Duane R. MacNeill
Surveyor's Michigan License No. 19237

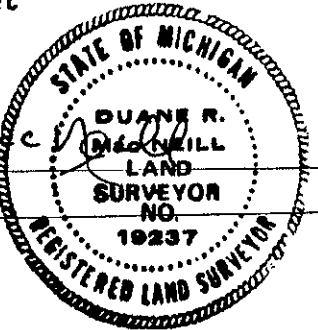

Date December 6, 1993