

MAY 16 1997

1996 ALPENA COUNTY REMONUMENTATION CORNER

LIBER

2 PAGE 42

COMMISSIONER

LAND CORNER RECORDATION CERTIFICATE

Filing Requirement of Act 74, Mich. P.A. 1970

For corners in

RECORDED  
ALPENA COUNTY MI.

JUL 22 11 07 AM '96

*Kathy G. Mitchell*  
REGISTER OF DEEDS

Register of Deeds Stamp & File Number

For corners in	Located In:	Corner Code #
<u>Alpena</u> (County)		
1. Public Land Survey	T <u>32N</u> R <u>8E</u>	<u>I-12, (W<math>\frac{1}{4}</math>, 35)</u> <u>Alpena Twp.</u>
	T _____ R _____	_____
	T _____ R _____	_____
	T _____ R _____	_____
2. Property Controlling in Section	S _____ T _____ R _____	_____
	S _____ T _____ R _____	_____
3. Miscellaneous Property in Section	S _____ T _____ R _____	_____
	S _____ T _____ R _____	_____

4. Lot No. \_\_\_\_\_, Recorded Plat \_\_\_\_\_  
5. Private Claims \_\_\_\_\_

	A	B	C	D	E	F	G	H	I	J	K	L	M
2	6		5		4		3		2				
3													
4	7		8		9		10		11		12		
5													
6	18		17		16		15		14		13		
7													
8	19		20		21		22		23		24		
9													
10	30		29		28		27		26		25		
11													
12	31		32		33		34		35		36		
13													

Thomas L. Fabis, in a field survey on May 9, 1996,  
do hereby certify that under requirements of P.A. 74, Michigan P.A. of 1970, the corner points mentioned in lines 1 and 2 above were in conformance with regulations and rules therefore as required in the current manual of survey instructions of the United States Department of the Interior, Bureau of Land Management or by a decree of a Court of Law and/or that the corner points mentioned in lines 3, 4 and 5 above were in conformance with the rules of the Michigan Board of Professional Surveyors or by a Decree of a Court of Law; established, re-established, monumented, re-monumented, recovered, found as expressed below:

NOTE: Not more than 4 corners, all in the same town and range, may be recorded on this certificate.

A. Description of original monument and accessories and/or subsequent restoration:

- 1855: G.L.O. Resurvey by Josiah Knauer - Set post & referenced: (Cedar 7 - S15 $\frac{1}{2}$ W-18, Cedar 10 - N9 $\frac{1}{2}$ E-12)
- 1893: County Survey by Joseph McNeil and Fred Rice - Set 1/4 s. 15 links East of Center of Road.
- 1977: Survey by Delmer Porter (Liber 1 Page 571) and L.C.R.C. by Ron Bischer (Liber 1 Page 93) - Found R.R. Spike and set 3 witnesses.

B. Description of corner evidence found and/or method applied in restoring or reestablishing corner:


- 1996: Found R.R. Spike and all 3 of Porter's witnesses as mentioned in Ron Bischer's L.C.R.C.

The position of this corner is compatible with county and local surveys and is accepted as a careful and faithful perpetuation of the position of the original corner.

P.A. 345 ALPENA COUNTY  
PEER APPROVED 5/16/96  
*Out B. Gton*

C. Description of monument for corner and accessories established to perpetuate locating the position of the corner:

- 1996: Removed R.R. Spike and set 1/2" iron rod capped with 3" dia. aluminum cap, stamped to identify the corner.  
Reestablished witnesses are:  
6" Cedar - N87E - 80.00'  
Anchor Pole - S41E - 40.97'  
T. Pole - S48W - 39.65'  
Set tag #31591 in 6" Cedar - N80W - 37.35'

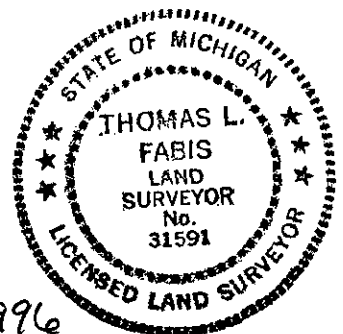

Signed by Thomas L. Fabis

Date July 17, 1996

Surveyor's Michigan License No. 31591