

MAY 18 1997

1996 ALPENA COUNTY REMONUMENTATION CORNER

004135

LIBER

2 PAGE 49

LAND CORNER RECORDATION CERTIFICATE

Filing Requirement of Act 74, Mich. P.A. 1970

For corners in

Alpena
(County)

Located In:

Corner Code #

1. Public Land Survey

T 31N R 8E

I-1 (NE, 3) ✓

T R

Alpena Twp.

T R

T 32N R 8E

I-13 (SE, 34) ✓

S T R

Alpena Twp.

S T R

S T R

S T R

2. Property Controlling
in Section

3. Miscellaneous

Property in Section

4. Lot No. _____, Recorded Plat _____

5. Private Claims _____

RECORDED
ALPENA COUNTY MI.

JUL 22 11 07 AM '96

Thomas L. Fabis
REGISTER OF DEEDS

Register of Deeds Stamp & File Number

I, Thomas L. Fabis, in a field survey on May 9, 1996

do hereby certify that under requirements of P.A. 74, Michigan P.A. of 1970, the corner points mentioned in lines 1 and 2 above were in conformance with regulations and rules therefore as required in the current manual of survey instructions of the United States Department of the Interior, Bureau of Land Management or by a decree of a Court of Law and/or that the corner points mentioned in lines 3, 4 and 5 above were in conformance with the rules of the Michigan Board of Professional Surveyors or by a Decree of a Court of Law; established, re-established, monumented, re-monumented, recovered, found as expressed below:

NOTE: Not more than 4 corners, all in the same town and range, may be recorded on this certificate.

A. Description of original monument and accessories and/or subsequent restoration:

- 1855: G.L.O. Resurvey by Josiah Knauer - Set post & referenced: (Y. Birch 8 - S51½E - 26 lks., Y. Birch 4 - S57W - 13 lks.)
- 1893: County Survey by Joseph McNeil - Visited corner.
- 1894: County Survey by Fred Rice - Visited corner.
- 1977: Survey (Liber 1 Page 571) by Delmer Porter and L.C.R.C. (Liber 1 Page 93) by Ron Bischer - 4" Conc. Mon. and set 3 witnesses.
- 1986: Survey (W.O. 4-237) by Earl Lewis - Ex. Conc. Mon. and set 2 new witnesses.

B. Description of corner evidence found and/or method applied in restoring or reestablishing corner:

1996: Found Concrete Monument and one of Lewis' witnesses.

The position of this corner is compatible with county and local surveys and is accepted as a careful and faithful perpetuation of the position of the original corner.

P.A. 345 ALPENA COUNTY
PEER APPROVED 5/16/96



Don B. Latta

C. Description of monument for corner and accessories established to perpetuate locating the position of the corner:

1996: Set 3" dia. aluminum cap, stamped to identify the corner, over the existing Concrete Monument.

Set tags #31591 in the following reestablished witnesses:

- P. Pole - N60W - 53.57'
- 3" Cedar - S56W - 48.59'
- 6" Spruce - N88E - 68.42'
- 8" Cedar - N65E - 81.83'

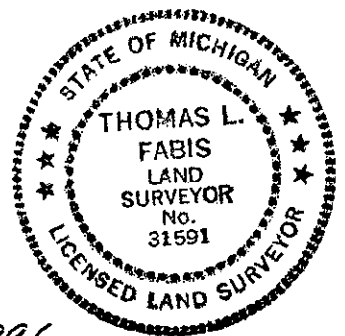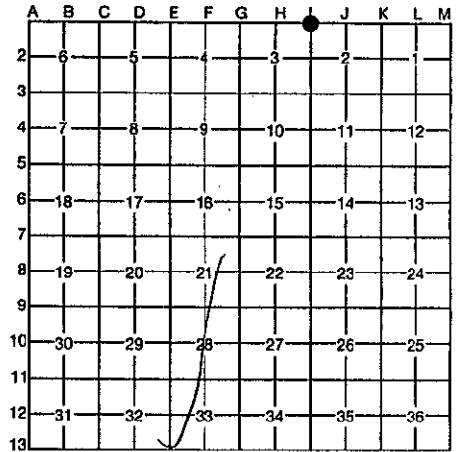

Signed by Thomas L. Fabis

Date July 17, 1996

Surveyor's Michigan License No. 31591