

# LAND CORNER RECORDATION CERTIFICATE

Filing Requirement of Act 74, Mich. PA 1970

For Corners In: \_\_\_\_\_  
 Alpena \_\_\_\_\_  
 (County) \_\_\_\_\_

		Located In		Corner Code #
1. Public Land Survey	T	32N	R 8E	M.C. S of M-4
	T	32N	R 8E	M.C. E. of L-5
2. Property Controlling in Section	S _____	T _____	R _____	_____
	S _____	T _____	R _____	_____
3. Miscellaneous Property in Section	S _____	T _____	R _____	_____
	S _____	T _____	R _____	_____


4. Lot No: \_\_\_\_\_ Recorded Plat: \_\_\_\_\_

5. Private Claims: \_\_\_\_\_

I, Carl T. Kiiskila, in a field survey on January 19, 2000 do hereby state that under requirements of PA 74, Michigan PA of 1970, the corner points mentioned in lines 1 and 2 above were in conformance with regulations and rules therefore as required in the current manual of survey instructions of the United States Department of the Interior, Bureau of Land Management or by a decree of a Court of Law and/or that the corner points mentioned in lines 3, 4 and 5 above were in conformance with the rules of the Michigan Board of Land Surveyors or by a Decree of a Court of Law; established, re-established, monumented, recovered, found as expressed below:

**NOTE: Not more than 2 corners, all in the same town and range, may be recorded on this certificate.**

Register of Deeds Stamp & File Number

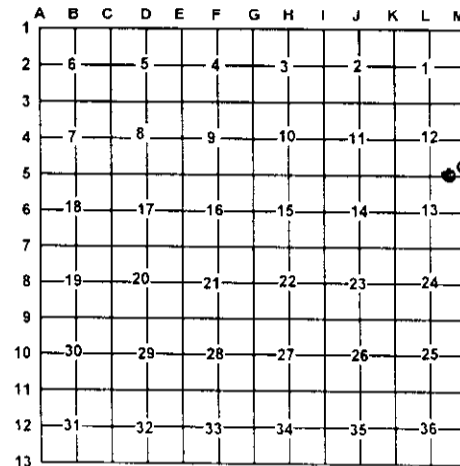

**A. Description of original monument and accessories and/or subsequent restoration:**

M.C. S of M-4 John Hodgson D.S. April 1840 used a 14" Aspen for meander post.

M.C. E of L-5 Josiah Knauer D.S. July 1855 intersected lake and set meander post.

Wit: W. Birch 12" N71°W 25 links  
 Cedar 4" N21°W 30 links

**B. Description of corner evidence found and/or method applies in restoring or re-establishing corner:**

M.C. S of M-4 Established a witness corner to the recorded meander corner established by John Hodgson D.S. in 1840. Set a 5/8" X 32" rered with P.S. cap 2262.79 feet South of M-4 on the East line of section 12.

M.C. E. of L-5 Established a witness corner to the recorded meander corner established by Josiah Knauer D.S. in July 1855. Set a 5/8" X 32" rered with P.S. cap 2484.69 feet East of L-5 on section line between section 12 and 13.

**C. Description of monument for corner and accessories established to perpetuate locating the position of the corner:**

M.C. S of M-4 Set 5/8" X 32" rered with P.S. cap #33981

Wit: 6" Cedar N03°E 5.34'  
 8" Cedar S21°E 4.93'  
 10" Twin Cedar N50°W 32.91'  
 14" Cedar S70°W 30.61'  
 Lake S06°W

M.C. E of L-5 Set 5/8" X 32" rered with P.S. cap #33981

Wit: 5" Twin White Birch N37°W 10.05'  
 5" White Birch S69°W 11.68'  
 3" Cedar N71°E 12.04'  
 8" Twin Cedar S32°E 9.02'  
 Lake East 90'  
 Carsonite Post North 1'±

Signed by: \_\_\_\_\_

*Carl T. Kiiskila*

Date: \_\_\_\_\_

12-10-03

Surveyor's Michigan License No.: 33981

