

LAND CORNER RECORDATION CERTIFICATE

Filing Requirement of Act 74, Mich. PA 1970

For Corners In:
Alpena Located In _____ Corner Code # _____
 (County)


1. Public Land Survey	T	32N	R	8E	L-6
	T	_____	R	_____	_____
2. Property Controlling in Section	S	13	T	32N	R 8E 9
	S	_____	T	_____	R _____
3. Miscellaneous Property in Section	S	_____	T	_____	R _____
	S	_____	T	_____	R _____

4. Lot No: _____ Recorded Plat: _____

5. Private Claims: _____

I, Carl T. Kiiskila, in a field survey on January 19, 2000 do hereby state that under requirements of PA 74, Michigan PA of 1970, the corner points mentioned in lines 1 and 2 above were in conformance with regulations and rules therefore as required in the current manual of survey instructions of the United States Department of the Interior, Bureau of Land Management or by a decree of a Court of Law and/or that the corner points mentioned in lines 3, 4 and 5 above were in conformance with the rules of the Michigan Board of Land Surveyors or by a Decree of a Court of Law, established, re-established, monumented, recovered, found as expressed below:

NOTE: Not more than 2 corners, all in the same town and range, may be recorded on this certificate.

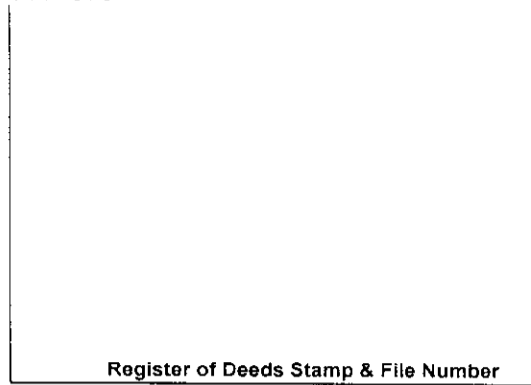

	A	B	C	D	E	F	G	H	I	J	K	L	M
1													
2	6		5		4		3		2		1		
3													
4	7		8		9		10		11		12		
5													
6	18		17		16		15		14		13		
7													
8	19		20		21		22		23		24		
9													
10	30		29		28		27		26		25		
11													
12	31		32		33		34		35		36		
13													

A. Description of original monument and accessories and/or subsequent restoration:

L-6 G.L.O. This corner position was not established during the original government survey

9 - G.L.O. This corner position was not established during the original government survey.

B. Description of corner evidence found and/or method applies in restoring or re-establishing corner:

L-6 Found and accepted a 4" concrete monument at center of section 13.

9- Established the Southeast corner of the Southwest quarter of the Northeast quarter of section 13 per B.L.M. instructions for the subdivision of a section.

C. Description of monument for corner and accessories established to perpetuate locating the position of the corner:

L-6 Found a 4" Concrete monument
 Wit: 4" Cedar N43°W 12.62'
 5" Cedar S35°W 28.46'
 10" Spruce S46°E 4.85'
 12" Cedar N30°E 5.34'

9- Set 5/8" X 32" rerod with P.S. cap #33981
 Wit: 8" Cedar N15°W 6.40'
 3" Balsam N65°E 20.42'
 5" Balsam S42°E 14.73'
 5" Spruce S74°W 10.11'
 Carsonite Post North 1'±

Signed by: _____

Carl T. Kiiskila

Date: _____

12-10-03

Surveyor's Michigan License No.: _____

33981

