

LAND CORNER RECORDATION CERTIFICATE

Filing Requirement of Act 74, Mich. PA 1970

For Corners In: Alpena Located In _____ Corner Code # _____
(County)

1. Public Land Survey	T	32N	R	8E	J-1
	T	_____	R	_____	_____
2. Property Controlling in Section	S	12	T	32 N	R 8 E
	S	_____	T	_____	R _____
3. Miscellaneous Property in Section	S	_____	T	_____	R _____
	S	_____	T	_____	R _____


4. Lot No: _____ Recorded Plat: _____

5. Private Claims: _____

I, Carl T. Kiiskila, in a field survey on January 19, 2000 do hereby state that under requirements of PA 74, Michigan PA of 1970, the corner points mentioned in lines 1 and 2 above were in conformance with regulations and rules therefore as required in the current manual of survey instructions of the United States Department of the Interior, Bureau of Land Management or by a decree of a Court of Law and/or that the corner points mentioned in lines 3, 4 and 5 above were in conformance with the rules of the Michigan Board of Land Surveyors or by a Decree of a Court of Law; established, re-established, monumented, recovered, found as expressed below:

NOTE: Not more than 2 corners, all in the same town and range, may be recorded on this certificate.

Register of Deeds Stamp & File Number

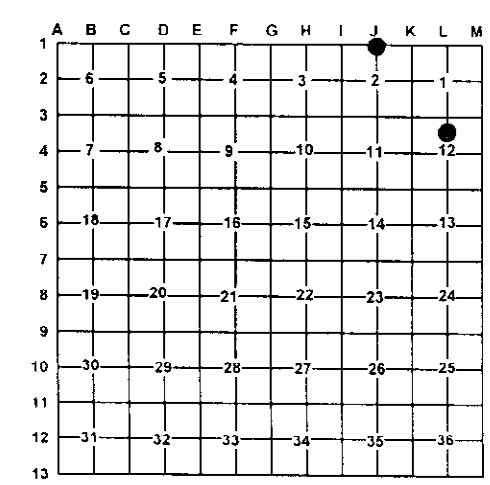

A. Description of original monument and accessories and/or subsequent restoration:

J-1 G.L.O. John Hodson, D.S. 1840 set quarter section post Wit: Sugar 20 N70°W 19 links Beech 8 N85°E 15 links	5- This corner position was not established during the original government survey
--	---

Pages 11 and 12 County Survey Notes September 1905
Joseph W. McNeil found everything gone, set a cedar stake on an East and West road on the Town line and on stone fences leading from this point.

B. Description of corner evidence found and/or method applies in restoring or re-establishing corner:

J-1 Re-established the North quarter corner of section 2 on the extension of an East and West road bed to the West and the West end of a large stone fence to the East. For Departure I extended the center of a section two thru the 3/4" pipe recorded in Liber 1, Page 172 by D.R. McNeil. This position falls on the East edge of an old clearing to the Southeast described by Joseph W. McNeil in his 1905 notes.	5- Established the Northwest corner of the Southwest quarter of the Northeast quarter of section 12 as per B.L.M. instructions for the subdivision of a section.
---	--

C. Description of monument for corner and accessories established to perpetuate locating the position of the corner:

J-1 Set standard DNR monument Wit: 9" Twin Cedar N56°E 6.10' 7" Maple Clump N67°W 23.98' 5" Cedar N17°W 24.20' 10" Maple S18°W 52.22' 3/4" Pipe S08°W 100.13'	5- 5/8" rerod with PS cap #33981 and carsonite post Wit: 6" Maple East 46.38' 3" Ash S50°E 29.29' 3" Balsam S09°W 57.43' 7" Poplar N61°W 12.35' ¢ of powerline East 130' ± Carsonite post North 1' ±
--	--

Signed by: Carl T. Kiiskila
Surveyor's Michigan License No.: 33981

Date: 12-10-03

