

LAND CORNER RECORDATION CERTIFICATE

Filing Requirement of Act 74, Mich. PA 1970

For Corners In:
Alpena Located In _____ Corner Code # _____
 (County)

1. Public Land Survey	T	<u>32N</u>	R	<u>8E</u>	<u>I-2</u>
	T	<u>32N</u>	R	<u>8E</u>	<u>L-4</u>
2. Property Controlling in Section	S	_____	T	_____	_____
	S	_____	T	_____	_____
3. Miscellaneous Property in Section	S	_____	T	_____	_____
	S	_____	T	_____	_____


4. Lot No: _____ Recorded Plat: _____

5. Private Claims: _____

I, Carl T. Kiiskila, in a field survey on, October 7, 2003 do hereby state that under requirements of PA 74, Michigan PA of 1970, the corner points mentioned in lines 1 and 2 above were in conformance with regulations and rules therefore as required in the current manual of survey instructions of the United States Department of the Interior, Bureau of Land Management or by a decree of a Court of Law and/or that the corner points mentioned in lines 3, 4 and 5 above were in conformance with the rules of the Michigan Board of Land Surveyors or by a Decree of a Court of Law; established, re-established, monumented, recovered, found as expressed below:

NOTE: Not more than 2 corners, all in the same town and range, may be recorded on this certificate.

Register of Deeds Stamp & File Number

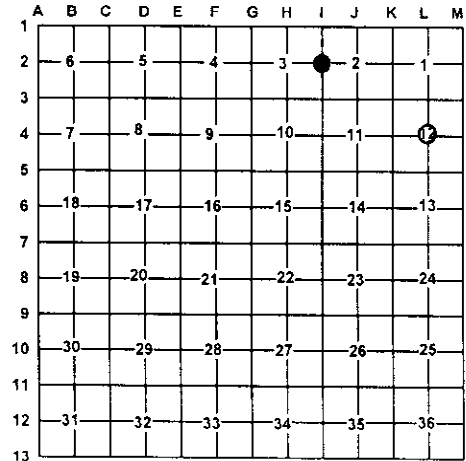

A. Description of original monument and accessories and/or subsequent restoration:

I-2 G.L.O. Josiah Knauer D.S. 1855 Set quarter section post Wit: Beech 8 S50°W 6 links Sugar 6 N70°E 13 links	L-4 R.S. Scott Engineering September 1975, unrecorded certificate of survey shows they set a railroad spike for the center of section 12. Wit: N45°E 8" Maple 45.20' N10°W 6" Maple 32.67' S30°E 6" Maple 33.35'
Earl T. Lewis P.S. #27452 set P.K. nail over found iron. Wit: 25" Maple N83°W 35.38' 21" Willow East 32.65' P. Pole S17°E 83.80' 27" Maple S56°W 43.70'	

B. Description of corner evidence found and/or method applies in restoring or re-establishing corner:

I-2 Found 1/2" iron bar set 1 1/4" X 24" pipe over top	L-4 Set 5/8" rerod with P.S. cap #33981 from information provided by R.S. Scott Engineering.
--	--

C. Description of monument for corner and accessories established to perpetuate locating the position of the corner:

I-2 Drove a 1 1/4" X 24" pipe over found 1/2" iron bar. Wit: Utility Pole S07°E 83.20' 26" Maple N88°W 35.21' 4" Well N88°E 41.20' 12" Ash S35°W 92.31'	L-4 Set 5/8" X 32" rerod with P.S. cap #33981 Wit: Utility Pole S05°W 24.93' Utility Pole N69°E 61.54' Conc. Mon. N09°E 32.81' 30" Maple S30°E 81.26'
---	---

Signed by: _____

Carl T. Kiiskila

Date: _____

12-10-03

Surveyor's Michigan License No.: _____

33981

