

MAY 16 1987

1996 ALPENA COUNTY REMONUMENTATION CORNER

004138

LIBER 2 PAGE 52

LAND CORNER RECORDATION CERTIFICATE

Filing Requirement of Act 74, Mich. P.A. 1970

For corners in

Alpena (County)

Located In:

Corner Code #

1. Public Land Survey

T 32N R 8E

M-11, (NE, 36)

T R

Alpena Twp.

T R

T 32N R 9E

A-11 (NW, 31)

S T R

Alpena Twp.

S T R

S T R

S T R

4. Lot No. , Recorded Plat

5. Private Claims

RECORDED ALPENA COUNTY MI.

JUL 22 11 07 AM '96

REGISTER OF DEEDS

Register of Deeds Stamp & File Number

A	B	C	D	E	F	G	H	I	J	K	L	M
2	6	5	4	3	2	1						
3												
4	7	8	9	10	11	12						
5												
6	18	17	16	15	14	13						
7												
8	19	20	21	22	23	24						
9												
10	30	29	28	27	26	25						
11												
12	31	32	33	34	35	36						
13												

I, Thomas L. Fabis, in a field survey on May 9, 1996, do hereby certify that under requirements of P.A. 74, Michigan P.A. of 1970, the corner points mentioned in lines 1 and 2 above were in conformance with regulations and rules therefore as required in the current manual of survey instructions of the United States Department of the Interior, Bureau of Land Management or by a decree of a Court of Law and/or that the corner points mentioned in lines 3, 4 and 5 above were in conformance with the rules of the Michigan Board of Professional Surveyors or by a Decree of a Court of Law; established, re-established, monumented, re-monumented, recovered, found as expressed below:

NOTE: Not more than 4 corners, all in the same town and range, may be recorded on this certificate.

A. Description of original monument and accessories and/or subsequent restoration:

- 1855: G.L.O. Resurvey by Josiah Knauer-Set post & referenced. (Cedar 7-S38W-7, Cedar 8-N44W-8).
- 1897: County Survey by Fred Rice - Found Old stake in Road.
- 1939: Cement Co. Railroad Survey by Wm. H. LeRoy - Shows corner 26.07' West of R.R. grade
- 1970: Survey(W.O.4-3939) by James Scott of R.S.Scott Eng. - Set R. Rod 13.6' West of R.R. grade
- 1977: Survey Notes(W.O.77118) by Farrier of Wilcox - Found 1/2" pipe 26.00' West of R.R. grade
- 1978: Survey (Liber 1 Page 890) by Duane MacNeil - Set 1" Pipe & referenced.
- 1979: L.C.R.C. (Liber 1 Page 109) and Survey (W.O.4-5844) by David Guthrie of R.S.Scott Assoc. - Found 1/2" Iron Rod set by Scott Eng. Co. in 1970 and referenced.
- 1987: Survey (W.O.4-7362) by David Guthrie of R.S.Scott Assoc. - Uses 1/2" iron rod corner position for a section breakdown.

B. Description of corner evidence found and/or method applied in restoring or reestablishing corner:

- 1996: Set 1/2" iron rod using 3 existing witnesses from Guthrie's L.C.R.C. and Survey of 1979.

The position of this corner best harmonizes with the 1/8 line fences to the East and West. It is compatible with county and local surveys and is accepted as a careful and faithful perpetuation of the position of the original corner.


P.A. 345 ALPENA COUNTY PEER APPROVED 5/16/96

C. Description of monument for corner and accessories established to perpetuate locating the position of the corner:

- 1996: Set 3" dia. aluminum cap, stamped to identify the corner, over the 1/2" iron rod.

Set tags #31591 in the following reestablished witnesses:

- 8" Cedar - N10E - 39.61'
- 5" Cedar - N45E - 45.00'
- 8" Cedar - S15W - 40.53'
- P. Pole - S35E - 40.74'

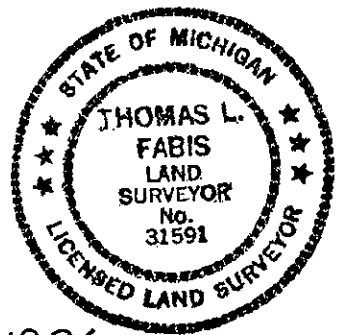

Signed by Thomas L. Fabis

Date July 17, 1996

Surveyor's Michigan License No. 31591