

LAND CORNER RECORDATION CERTIFICATE

Filing Requirement of Act 74, Mich. PA 1970

For Corners In:
Alpena Located In _____ Corner Code # _____
 (County)

1. Public Land Survey T _____ R _____
 T _____ R _____

2. Property Controlling in Section S 8 T 32N R 9E M.C. E of C-4
 S _____ T _____ R _____

3. Miscellaneous Property in Section S _____ T _____ R _____
 S _____ T _____ R _____

4. Lot No: _____ Recorded Plat: _____

5. Private Claims: _____

I, Carl T. Kiiskila, in a field survey on January 19, 2000 do hereby state that under requirements of PA 74, Michigan PA of 1970, the corner points mentioned in lines 1 and 2 above were in conformance with regulations and rules therefore as required in the current manual of survey instructions of the United States Department of the Interior, Bureau of Land Management or by a decree of a Court of Law and/or that the corner points mentioned in lines 3, 4 and 5 above were in conformance with the rules of the Michigan Board of Land Surveyors or by a Decree of a Court of Law; established, re-established, monumented, recovered, found as expressed below:

NOTE: Not more than 2 corners, all in the same town and range, may be recorded on this certificate.

Register of Deeds Stamp & File Number

	A	B	C	D	E	F	G	H	I	J	K	L	M
1													
2	6		5		4		3		2		1		
3													
4	7		8		9		10		11		12		
5													
6	18		17		16		15		14		13		
7													
8	19		20		21		22		23		24		
9													
10	30		29		28		27		26		25		
11													
12	31		32		33		34		35		36		
13													

A. Description of original monument and accessories and/or subsequent restoration:

M.C. E. of C-4 Consumers Power Co. map May 1990, shows a bearing and distance to the corner. Type of monument was not given. C-4 to M.C. E. of C-4 has a recorded distance of 510.27' we measured 509.85'


B. Description of corner evidence found and/or method applies in restoring or re-establishing corner:

M.C. E. of C-4 Found a 1/2" capped iron rod with P.S. cap #22435 (David B. Guthrie) fitting Consumers Power Co. survey in the area.

C. Description of monument for corner and accessories established to perpetuate locating the position of the corner:

M.C. E of C-4 1/2" iron rod with P.S. cap #22435
 wit: *4" Cedar S27°E 19.37'
 5" Cedar S15°W 40.09'
 *6" Tamarack S72°W 80.04'
 3" Cedar N48°W 45.55'
 Shore of Lake Huron East 100'±

*Old witnesses by others

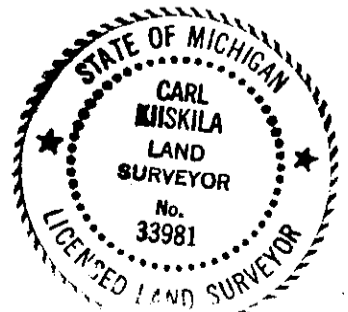

Signed by: Carl T. Kiiskila
 Surveyor's Michigan License No.: 33981

Date: 12-10-03