

FEB 18 1999

105-166-107-168

Liber 00003 Page 0017

SECTION

LAND CORNER RECORDATION CERTIFICATE
Filing Requirement of Act 74, Mich. P.A. 1970

ANTRIM COUNTY MI.
Register of Deeds
Recorded

For corners in

<u>Antrim</u> (County)	Located In:	MILTON Corner Code #
1. Public Land Survey	Sec. 36 T29N R.9W	M-13
	Sec. 31 T29N R.8W	A-13
	Sec. 1 T28N R.9W	M-1
	Sec. 6 T28N R.8W	A-1 ✓
2. Property Controlling in Section	S ___ T ___ R ___	___
3. Miscellaneous Property in Sec.	S ___ T ___ R ___	___

12-15-1998 10:15:38

Wanda R. Conway
REGISTER OF DEEDS

Register of Deeds Stamp & File Number

4. Lot No. _____, Recorded Plat _____
5. Private Claims _____

I, Terry B. Smith, in a field survey on 12-10, 1998 do hereby state that under requirements of P.A. 74, Michigan P.A. of 1970, the corner points mentioned in lines 1 and 2 above were in conformance with regulations and rules therefore as required in the current manual of survey instructions of the United States Department of the Interior, Bureau of Land Management or by a decree of a Court of Law and /or that the corner points mentioned in lines 3, 4 and 5 above were in conformance with the rules of the Michigan Board of Land Surveyors or by a Decree of a Court of Law; established, re-established, monumented, recovered, found as expressed below:

NOTE: Not more than 2 corners, all in the same town and range, may be recorded on this certificate.

	A	B	C	D	E	F	G	H	I	J	K	L	M
1													
2	6		5		4		3		2		1		
3													
4	7		8		9		10		11		12		
5													
6	18		17		16		15		14		13		
7													
8	19		20		21		22		23		24		
9													
10	30		29		28		27		26		25		
11													
12	31		32		33		34		35		36		
13													

A. Description of original monument and accessories and/or subsequent restoration:

GLO circa 1853 no evidence found
County Surveyor's records circa 1901
Plat reference -- LYNNSDALE ACRES

B. Description of corner evidence found and/or method applied in restoring or reestablishing corner:


Found 1 1/2" steel pipe pre plat

Ratified by peer group
in accordance with
P.O. 345
Antrim Co. Chairman

Arthur L. Lennox
Arthur L. Lennox
Nov. 18, 1998

C. Description of monument for corner and accessories established to perpetuate locating the position of the corner:

Set Antrim County Monument
1/2" steel bar North 33.00
30" W. Pine S75W 35.31
8" Oak N15E 40.24
30" Oak S70E 85.29

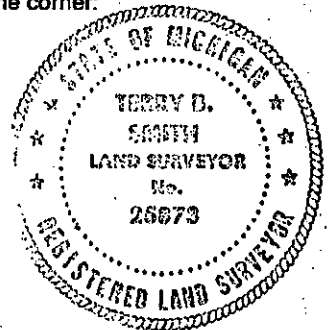

Signed by Terry B. Smith
Surveyor's Michigan License No. 25873

Date DEC. 14, 1998