

FEB 18 1999

163-164

Liber 00003 Page 0016

SECTION

LAND CORNER RECORDATION CERTIFICATE
Filing Requirement of Act 74, Mich. P.A. 1970

ANTRIM COUNTY MI.
Register of Deeds
Recorded

For corners in

Antrim
(County)

Located In:

MILTON
Corner Code #

12-15-1998 10:15:23

Wanda R. Conway
REGISTER OF DEEDS

- 1. Public Land Survey Sec 1 T 28NR 9W M-2
- Sec. 6 T 28N R 8W A-2 ✓
- T R
- T R
- 2. Property Controlling in Section S T R
- S T R
- 3. Miscellaneous S T R
- Property in Sec. S T R

Register of Deeds Stamp & File Number

- 4. Lot No. _____, Recorded Plat _____
- 5. Private Claims _____

I, Terry B. Smith, in a field survey on 12-10-98 do hereby state that under requirements of P.A. 74, Michigan P.A. of 1970, the corner points mentioned in lines 1 and 2 above were in conformance with regulations and rules therefore as required in the current manual of survey instructions of the United States Department of the Interior, Bureau of Land Management or by a decree of a Court of Law and/or that the corner points mentioned in lines 3, 4 and 5 above were in conformance with the rules of the Michigan Board of Land Surveyors or by a Decree of a Court of Law; established, re-established, monumented, recovered, found as expressed below:

NOTE: Not more than 2 corners, all in the same town and range, may be recorded on this certificate.

	A	B	C	D	E	F	G	H	I	J	K	L	M
1													
2	6		5		4		3		2		1		
3													
4	7		8		9		10		11		12		
5													
6	16		17		16		15		14		13		
7													
8	19		20		21		22		23		24		
9													
10	30		29		28		27		26		25		
11													
12	31		32		33		34		35		36		
13													

A. Description of original monument and accessories and/or subsequent restoration:

GL0 circa 1853 no evidence found
County Surveyors notes circa 1901
certificates: B. Jones 1990
A. Lennox 1977, 1995, 1996
B. Batzer 1968

Ratified by peer group
in accordance with
P.O. 345
Antrim Co. Chairman


Arthur L. Lennox
Arthur L. Lennox
Nov. 18, 1998

B. Description of corner evidence found and/or method applied in restoring or reestablishing corner:

Found pipe per certificates

C. Description of monument for corner and accessories established to perpetuate locating the position of the corner:

Set Antrim County Monument
4" Maple N80E 29.40
10" Oak N65W 16.40
14" Beech S05E 42.80
14" Tw Oak S40W 18.75

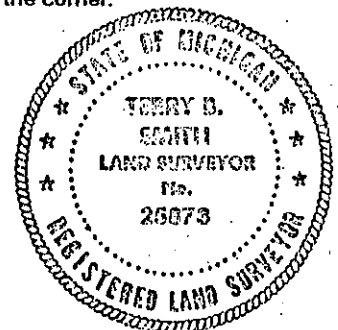

Signed by *Terry B. Smith*
Surveyor's Michigan License No. 25873

Date DEC. 14, 1998