

MAY 10 1999

SECTION

CORNER RECORDATION CERTIFICATE
Filing Requirement of Act 74, Mich. P.A. 1970

KALKASKA COUNTY, MICHIGAN
RECEIVED
1994 DEC 23 AM 9:30
Joan Hall
REG. OF DEEDS

corners in

<u>KALKASKA</u> (County)	Located In:	Corner Code #
1994 REMONUMENTATION	T 28N R 8W	E-7
Public Land Survey	T R	
	T R	
	T R	
Property Controlling	S T R	
in Section	S T R	
Miscellaneous	S T R	
Property in Sec.	S T R	

Register of Deeds Stamp & File Number

Lot No. _____, Recorded Plat _____
Private Claims _____

A	B	C	D	E	F	G	H	I	J	K	L	M
2	6	5	4	3	2	1						
3												
4	7	8	9	10	11	12						
5												
6	18	17	16	15	14	13						
7												
8	19	20	21	22	23	24						
9												
10	30	29	28	27	26	25						
11												
12	31	32	33	34	35	36						
13												

EUGENE FARRIER, in a field survey on Nov. 12, 1994,
hereby certify that under requirements of P.A. 74, Michigan P.A. of 1970, the corner points mentioned
lines 1 and 2 above were in conformance with regulations and rules therefore as required in the
ent manual of survey instructions of the United States Department of the Interior, Bureau of Land
agement or by a decree of a Court of Law and/or that the corner points mentioned in lines 3, 4 and 5
ve were in conformance with the rules of the Michigan Board of Land Surveyors or by a Decree of a
rt of Law; established, re-established, monumented, re-monumented, recovered, found as
ressed below:

**TE: Not more than 4 corners, all in the same town and range, may be recorded
on this certificate.**

Description of original monument and accessories and/or subsequent restoration:

- E-7: Cor. common to Sec. 16, 17, 20 & 21, T28N-R8W, 1850 GLO re-survey: set post, Beech 10", S31E, 36, Beech 8", N68W, 34 7-2-1879, E. McVee, fd cor. stake, no accessories
- 6-1-73, J.H. Granger, fd hex bolt at cor, w/access, Lib 1 Pg's 356 & 362
- 6-8-73, LCRC (J.H. Granger), fd hex bolt, w/accessories, Lib. 1 Pg 235.
- 11-27-79 & 6-26-80, A.L. Dragoo, fd cor. bolt, w/accessories, Lib. 2 Pg's 495, 496 & 563
- 9-21-83, Kalkaska Co Rd Comm., fd cor. 1 1/2" sq. bolt, w/accessories
- 6-10-84, E. Farrier, fd 1" bolt, no accessories, Lib. 1 Pg 360.
- 2-3-87, E. Farrier, fd 1 1/2" sq/ bolt, w/accessories
- 5-21-93, B.M. Jones, fd cor hex bolt, w/access., Lib 4 Pg's 155 & 153


Description of corner evidence found and/or method applied in restoring or reestablishing corner:

E-7: Cor. common to Sec. 16, 17, 20 & 21, T28N-R8W,
SW cor. Sec. 16, T28N-R8W, fd 1 1/2" sq. bolt in centerline rd. int.
replaced with 5/8" x 36" re-bar & brass cap, 0.6' below gravel rd.
On 12-20-94 the Kalkaska Co. peer group approved the above monument as a
careful and faithful reestablishment of the position of the original
corner.

Description of monument for corner and accessories established to perpetuate locating the position of the corner:

- E-7: Cor. common to Sec. 16, 17, 20 & 21, T28N-R8W, SW cor. Sec. 16, T28N-R8W, fd 1 1/2" sq. bolt in centerline rd. int. replaced with 5/8" x 36" re-bar & brass cap, 0.6' below gravel rd.
- Fd nail - P. Pole, S27E - 62.34'
- Fd nail - 18" Cherry, S42W - 88.40'
- Fd nail - 10" W. Pine, S83W - 41.75'
- Fd nail - 12" W. Pine, N33W - 67.73'

Ratified by Peer Group
P.A. 345-1990 Kalkaska County
Chairman Eugene Farrier
Date 12-20-94

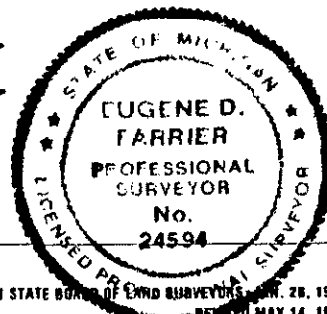

ed by Eugene Farrier

Date 12-22-94

eyor's Michigan License No. 24594