

SURVEY & REMONUMENTATION

MAY 10 1999

SECTION

LAND CORNER RECORDATION CERTIFICATE
Filing Requirement of Act 74, Mich. P.A. 1970

KALKASKA COUNTY, MI RECEIVED
1994 DEC 23 AM 9:31
Jean Hall
REG. OF DEEDS

corners in

<u>KALKASKA</u> (County)	Located In:	Corner Code #
1994 REMONUMENTATION		
Public Land Survey	T <u>28N</u> R <u>8W</u>	<u>F-1</u>
	T _____ R _____	_____
	T _____ R _____	_____
	T _____ R _____	_____
Property Controlling in Section	S _____ T _____ R _____	_____
Miscellaneous	S _____ T _____ R _____	_____
Property in Sec.	S _____ T _____ R _____	_____

Register of Deeds Stamp & File Number

Lot No. _____, Recorded Plat _____
Private Claims _____

	A	B	C	D	E	F	G	H	I	J	K	L	M
2	6		5		4		3		2				
3													
4	7		8		9		10		11		12		
5													
6	16		17		18		15		14		13		
7													
8	19		20		21		22		23		24		
9													
10	30		29		28		27		26		25		
11													
12	31		32		33		34		35		36		
13													

EUGENE FARRIER, in a field survey on Nov. 12, 1994, hereby certify that under requirements of P.A. 74, Michigan P.A. of 1970, the corner points mentioned in lines 1 and 2 above were in conformance with regulations and rules therefore as required in the present manual of survey instructions of the United States Department of the Interior, Bureau of Land Management or by a decree of a Court of Law and/or that the corner points mentioned in lines 3, 4 and 5 above were in conformance with the rules of the Michigan Board of Land Surveyors or by a Decree of a Court of Law; established, re-established, monumented, re-monumented, recovered, found as pressed below:

NOTE: Not more than 4 corners, all in the same town and range, may be recorded on this certificate.

Description of original monument and accessories and/or subsequent restoration:

F-1: Cor. common to Sec. 4, T28N-R8W, Kalkaska Co., and Sec. 33, T29N-R8W, Antrim Co.
1850 GLO re-survey: set post, Hemlock 14" N78E, 21, Maple 10" N82W, 12.
8-11-11, W.S. Merrill-Co. Surv., noted stone cor., no accessories
11-12-38, Kalkaska Co Rd Comm., fd cor., no accessories
11-27-59, A.G. Erickson, fd iron, no accessories
8-70 to 7-91, Certificates of Survey, fd 1/2" or 3/4" pipe in Mon. Box, C.E. Ostling (Lib 1 Pg 233), A. Lennox (Lib 1 Pg 948, Lib 240 Pg 85), J.L. Fletcher (Lib 2 Pg's 223 & 254), B.M. Jones (Lib 3 Pg 309, Lib 364 Pg 339, Lib 299 Pg 650), E. Farrier (Lib 344 Pg 619), N.B. Livasy (Lib 3 Pg 217)
10-17-72, LCRC (C.E. Ostling), fd 3/4" iron, w/access., Lib. 1 Pg 147.
7-20-78, LCRC (J.L. Fletcher), fd 3/4" rod in Mon box, w/access, Lib 2 Pg 110
9-23-83, LCRC (B.M. Jones), fd cor., w/accessories, Lib. 2 Pg 329
3-15-85, LCRC (B.M. Jones), fd cor., w/accessories, Lib. 2 Pg 14

Description of corner evidence found and/or method applied in restoring or reestablishing corner:


F-1: Cor. common to Sec. 4, T28N-R8W, Kalkaska Co., and Sec. 33, T29N-R8W, Antrim Co.
North 1/4 cor. Sec. 4, T28N-R8W, fd 3/4" iron bar in centerline Crystal Beach Rd 2' West centerline Rapid City Rd. Pulled & replaced with 5/8" x 18" re-bar with brass cap, 0.3' below rd. surface. No GLO witness were found.

On 12-20-94 the Kalkaska Co. peer group approved the above monument as a careful and faithful reestablishment of the position of the original corner.

Description of monument for corner and accessories established to perpetuate locating the position of the corner:

F-1: Cor. common to Sec. 4, T28N-R8W, Kalkaska Co., and Sec. 33, T29N-R8W, Antrim Co.
North 1/4 cor. Sec. 4, T28N-R8W, fd 3/4" iron bar in centerline Crystal Beach Rd. 2' west centerline Rapid City Rd. Pulled & replaced with 5/8" x 18" re-bar with brass cap 0.3 below rd. surface.
Fd nail 30" W. Pine, S75E, 150.35
Fd nail 40" Oak, S59E, 63.18
Fd nail P.P., S25W, 94.72
Fd nail P.P., N02W, 70.82
Fd nail P.P., N36E, 113.19

Ratified by Peer Group
P.A. 345-1990 Kalkaska County
Chairman *Eugene Farrier*
Date 12-20-94

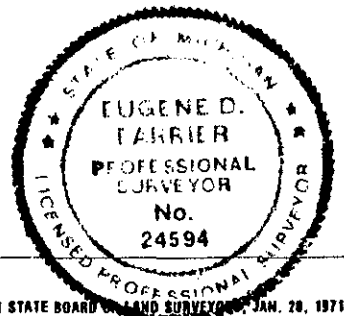

Surveyed by *Eugene Farrier*
Surveyor's Michigan License No. 24594

Date 12-22-94