

**SURVEY & REMONUMENTATION**

MAY 10 1999

SECTION

**LAND CORNER RECORDATION CERTIFICATE**  
Filing Requirement of Act 74, Mich. P.A. 1970

KALKASKA COUNTY, MICHIGAN  
RECEIVED

1994 DEC 23 AM 9:31

*Jean Hall*  
REG. OF DEEDS

or corners in

<u>KALKASKA</u> (County)	Located in:	Corner Code #
1994 REMONUMENTATION		
Public Land Survey	T <u>28N</u> R <u>8W</u>	<u>F-3</u>
	T _____ R _____	_____
	T _____ R _____	_____
	T _____ R _____	_____
Property Controlling in Section	S _____ T _____ R _____	_____
Miscellaneous	S _____ T _____ R _____	_____
Property in Sec.	S _____ T _____ R _____	_____

Register of Deeds Stamp & File Number

Lot No. \_\_\_\_\_, Recorded Plat \_\_\_\_\_  
Private Claims \_\_\_\_\_

EUGENE FARRIER, in a field survey on Nov. 12, 19 94, hereby certify that under requirements of P.A. 74, Michigan P.A. of 1970, the corner points mentioned in lines 1 and 2 above were in conformance with regulations and rules therefore as required in the present manual of survey instructions of the United States Department of the Interior, Bureau of Land Management or by a decree of a Court of Law and/or that the corner points mentioned in lines 3, 4 and 5 above were in conformance with the rules of the Michigan Board of Land Surveyors or by a Decree of a Court of Law; established, re-established, monumented, re-monumented, recovered, found as pressed below:

**NOTE: Not more than 4 corners, all in the same town and range, may be recorded on this certificate.**

Description of original monument and accessories and/or subsequent restoration:

F-3: Cor. common to Sec. 4 & 9, T28N-R8W.  
1850 GLO re-survey: set post, Beech 12" N45W, 40, Beech 6" S16E, 11.  
1885-1891, E. Mosher (Co S.) visit cor., no cor. ident., w/accessories  
1902-1911, W.S. Merrill (Co. S.), visit cor, no accessories  
12-15-71, LCRC (C.E. Ostling), fd 1 1/2" pipe, w/access., Lib. 1 Pg 51  
12-71 to 8-85, Certificates of Survey, all fd 1 1/2" pipe, C.E. Ostling (Lib 1 Pg's 77, 79 & 233), L.R. Feindt (Lib 163 Pg 408), A. Lennox (Lib 2 Pg 309), B.M. Jones (Lib 2 Pg 539), Kalkaska Co. Rd. Comm. (notes iron), E. Farrier (notes iron)  
10-17-72, LCRC (C.E. Ostling), fd 1 1/2" pipe, w/access., Lib. 1 Pg 147.  
11-2-78, LCRC (A. Lennox), fd 1 1/2" pipe, w/accessories, Lib. 2 Pg 166

Description of corner evidence found and/or method applied in restoring or reestablishing:

Validated by Peer Group  
P.A. 345 - 1990 Kalkaska County

Chairman *Eugene Farrier*  
Date 12-20-94


F-3: Cor. common to Sec. 4 & 9, T28N-R8W.  
Fd 1 1/2" iron pipe, set 5/8" x 3' re-rod in center of pipe w/co. cap., 125' E of centerline Rapid City Rd. No GLO witnesses found.  
On 12-20-94 the Kalkaska Co. peer group approved the above monument as a careful and faithful reestablishment of the position of the original corner.

Description of monument for corner and accessories established to perpetuate locating the position of the corner:

F-3: Cor. common to Sec. 4 & 9, T28N-R8W.  
Fd 1 1/2" iron pipe, set 5/8" x 3' re-rod in center of pipe w/co. cap., 125' E of centerline Rapid City Rd.  
Fd nail in N. face P. Pole S89W, 31.39'  
Fd nail in W. side 8" Poplar N26E, 7.82'  
Fd nail in NE side Twin 6" Maple, S50E, 12.54'  
Fd cut off P. Pole set nail in nail & tag in center, 12.01'  
Set nail & tag in 3" Oak, S70W, 18.96  
Set nail & tag in 10" Maple, S05W, 64.19

Witnessed by *Eugene Farrier*  
Surveyor's Michigan License No. 24594

Date 12-22-94

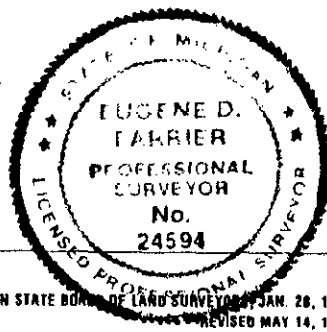

FORM APPROVED BY MICHIGAN STATE BOARD OF LAND SURVEYORS, JAN. 28, 1971  
REVISED MAY 14, 1975  
REVISED JAN., 1983