

SURVEY & REMONUMENTATION

MAY 10 1999

KALKASKA COUNTY, MICHIGAN RECEIVED

1994 DEC 23 AM 9:31

SECTION

4th CORNER RECORDATION CERTIFICATE
 Filing Requirement of Act 74, Mich. P.A. 1970

Jean Hall
 REG. OF DEEDS

corners in

KALKASKA (County)	Located In:	Corner Code #
1994 REMONUMENTATION		
Public Land Survey	T <u>28N</u> R <u>8W</u>	<u>F-7</u>
	T _____ R _____	_____
	T _____ R _____	_____
	T _____ R _____	_____
Property Controlling in Section	S _____ T _____ R _____	_____
Miscellaneous	S _____ T _____ R _____	_____
Property in Sec.	S _____ T _____ R _____	_____

Register of Deeds Stamp & File Number

Lot No. _____ Recorded Plat _____
 Private Claims _____

	A	B	C	D	E	F	G	H	I	J	K	L	M
2	6	5	4	3	2	1							
3													
4	7	8	9	10	11	12							
5													
6	18	17	16	15	14	13							
7													
8	19	20	21	22	23	24							
9													
10	30	29	28	27	26	25							
11													
12	31	32	33	34	35	36							
13													

EUGENE FARRIER, in a field survey on Nov. 12, 1994, hereby certify that under requirements of P.A. 74, Michigan P.A. of 1970, the corner points mentioned lines 1 and 2 above were in conformance with regulations and rules therefore as required in the current manual of survey instructions of the United States Department of the Interior, Bureau of Land Management or by a decree of a Court of Law and/or that the corner points mentioned in lines 3, 4 and 5 above were in conformance with the rules of the Michigan Board of Land Surveyors or by a Decree of a Court of Law; established, re-established, monumented, re-monumented, recovered, found as pressed below:

NOTE: Not more than 4 corners, all in the same town and range, may be recorded on this certificate.

Description of original monument and accessories and/or subsequent restoration:

F-7: Cor. common to Sec. 16 & 21, T28N-R8W.
 1850 GLO re-survey: set post, Hemlock 14" S73E, 14, Hemlock 8" N34W, 23.
 11-29-1879, J.R. Jenkins, visit cor. for Smith Add. to R.C., no access.
 6-3-1882, E. Mosher, visit cor., no accessories
 7-25-00, Unknown Co Sur., fd post under hghwy., no accessories
 6-8-73, J.H. Granger, fd 1/2" iron, w/accessories, Lib 1 Pg 235
 1966, Kalkaska Co. Rd Comm., fd iron stake for rd. const., w/accessories
 6-73 to 1-94, Certificates of Survey, all fd 1/2" iron: J.H. Granger (Lib 1 Pg 362), Gourdie Fraser & Assoc. (Lib 1 Pg's 493 & 516), R.C. Dunn (Lib 160 Pg 738), A. Lennox (Lib 2 Pg 29), A.L. Dragoo (Lib 2 Pg's 104, 496, 495, 563), B.M. Jones (Lib 4 Pg's 153 & 155), Farrier Surv. (Lib 1 Pg 360, Lib 2 Pg 496, Lib 3 Pg's 293 & 103)

Ratified by Peer Group
 P.A. 345 - 1990 Kalkaska County

Chairman *Eugene Farrier*


Date 12-22-94

Description of corner evidence found and/or method applied in restoring or reestablishing corner:

F-7: Cor. common to Sec. 16 & 21, T28N-R8W.
 Fd 1/2" rod 2.5 ft. long in centerline int. Rapid City Rd. & Schneider Rd.
 Pulled & replaced with 5/8" x 18" re-bar w/brass cap 0.4 below rd. surface; set Mon. box. No GLO witnesses were fd.
 On 12-20-94 the Kalkaska Co. peer group approved the above monument as a careful and faithful reestablishment of the position of the original corner.

Description of monument for corner and accessories established to perpetuate locating the position of the corner:

F-7: Cor. common to Sec. 16 & 21, T28N-R8W.
 Fd 1/2" rod 2.5 ft. long in centerline int. Rapid City Rd. & Schneider Rd.
 Pulled & replaced with 5/8" x 18" re-bar w/brass cap 0.4 below rd. surface; set Mon. box. No GLO witnesses were fd.
 Set nail P. Pole S35E, 48.83
 Set nail P. Pole S55W, 43.91
 Set nail P. Pole S83W, 109.68
 Set nail P. Pole N02W, 235.00

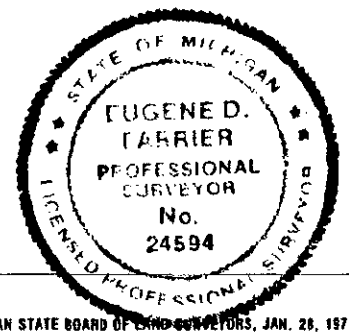

Witnessed by *Eugene Farrier*
 Surveyor's Michigan License No. 24594

Date 12-22-94