

**SURVEY & REMONUMENTATION**

MAY 10 1999

KALKASKA COUNTY, MICHIGAN  
RECEIVED

1994 DEC 23 AM 9:31

**SECTION**

**CORNER RECORDATION CERTIFICATE**

Meeting Requirement of Act 74, Mich. P.A. 1970

*Jean Hall*  
REG. OF DEEDS

corners in

<u>KALKASKA</u> (County)	Located In:	Corner Code #
1994 REMONUMENTATION		
Public Land Survey	T 28N R 8W	F-11
	T R	
	T R	
	T R	
Property Controlling in Section	S T R	
Miscellaneous	S T R	
Property in Sec.	S T R	

Register of Deeds Stamp & File Number

Lot No. \_\_\_\_\_, Recorded Plat \_\_\_\_\_  
Private Claims \_\_\_\_\_

	A	B	C	D	E	F	G	H	I	J	K	L	M
2	6		5		4		3		2				
3													
4	7		8		9		10		11		12		
5													
6	18		17		16		15		14		13		
7													
8	19		20		21		22		23		24		
9													
10	30		29		28		27		26		25		
11													
12	31		32		33		34		35		36		
13													

EUGENE FARRIER in a field survey on Nov. 12, 1994, hereby certify that under requirements of P.A. 74, Michigan P.A. of 1970, the corner points mentioned lines 1 and 2 above were in conformance with regulations and rules therefore as required in the current manual of survey instructions of the United States Department of the Interior, Bureau of Land Management or by a decree of a Court of Law and/or that the corner points mentioned in lines 3, 4 and 5 above were in conformance with the rules of the Michigan Board of Land Surveyors or by a Decree of a Court of Law; established, re-established, monumented, re-monumented, recovered, found as pressed below:

**NOTE: Not more than 4 corners, all in the same town and range, may be recorded on this certificate.**

Description of original monument and accessories and/or subsequent restoration:

F-11: Cor. common to Sec. 28 & 33, T28N-R8W  
1850 GLO re-survey: set post, Hemlock 10", N75W, 7, Cedar 6", S35E, 5  
1-6-1876, D.E. McVee, noted cor., no accessories  
6-18 & 19-1884, E. Mosher, notes cor., no accessories  
8-14-02, W.S. Merrill, fd stake at center set by Mosher, no accessories  
6-27-06, W.S. Merrill, used cor., w/accessories  
4-6-09, W.S. Merrill, set iron stake at cor., no accessories  
2-57, Forestry Div. Dep't of Conservation, set temp. 1/4 post at mid-point on line, no/accessories  
11-4-71, LCRC(J.L. Fletcher), fd hewed post, reset 1/2" iron, w/access  
3-30-90, E. Farrier, notes cor., no access.

1. Description of corner evidence found and/or method applied in restoring or reestablishing corner:


F-11: Cor. common to Sec. 28 & 33, T28N-R8W  
Fd 1/2" R.B. w/cap #19830 18" long. Pulled & replaced w/alu. cap 0.3 above ground surface. No GLO witness were fd.  
On 12-20-94 the Kalkaska Co. peer group approved the above monument as a careful and faithful reestablishment of the position of the original corner.

Ratified by Peer Group  
P.A. 345 - 1990 Kalkaska County

Chairman *Eugene Farrier*

Description of monument for corner and accessories established to perpetuate local position of the corner: 12-22-94

F-11: Cor. common to Sec. 28 & 33, T28N-R8W  
Fd 1/2" R.B. w/cap #19830 18" long. Pulled & replace w/alu. cap 0.3 above ground surface.  
Set nail & tag N05W, 8" W. Pine, 30.38'  
Fd nail N18E, 4" Cedar, 9.35'  
Fd nail S11E, 10" W. Pine, 14.98'  
Fd nail S44W, 8" W. Pine, 25.46'  
Fd nail N51W, 15" W. Pine, 33.46'

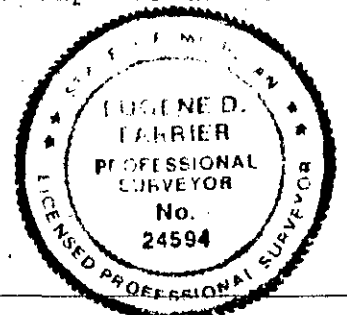

Surveyed by *Eugene Farrier*

Date 12-22-94

Surveyor's Michigan License No. 24594