

**SURVEY &
REMONUMENTATION**

JUL 02 1999

SECTION

**LAND CORNER RECORDATION CERTIFICATE
Filing Requirement of Act 74, Mich. P.A. 1970**

For corners in

<u>KALKASKA</u>	Located In:	Corner Code #
(County)		
1994 REMONUMENTATION		
1. Public Land Survey	T <u>28N</u> R <u>8W</u>	<u>G-4</u>
	T _____ R _____	_____
	T _____ R _____	_____
	T _____ R _____	_____
2. Property Controlling	S _____ T _____ R _____	_____
in Section	S _____ T _____ R _____	_____
3. Miscellaneous	S _____ T _____ R _____	_____
Property in Sec.	S _____ T _____ R _____	_____

Register of Deeds Stamp & File Number

4. Lot No. _____, Recorded Plat _____

5. Private Claims _____

	A	B	C	D	E	F	G	H	I	J	K	L	M
1													
2	6		5		4		3		2		1		
3													
4	7		8		9		10		11		12		
5													
6	18		17		16		15		14		13		
7													
8	19		20		21		22		23		24		
9													
10	30		29		28		27		26		25		
11													
12	31		32		33		34		35		36		
13													

I, EUGENE FARRIER, in a field survey on September 26, 1997 do hereby state that under requirements of P.A. 74, Michigan P.A. of 1970, the corner points mentioned in lines 1 and 2 above were in conformance with regulations and rules therefore as required in the current manual of survey instructions of the United States Department of the Interior, Bureau of Land Management or by a decree of a Court of Law and /or that the corner points mentioned in lines 3, 4 and 5 above were in conformance with the rules of the Michigan Board of Land Surveyors or by a Decree of a Court of Law; established, re-established, monumented, recovered, found as expressed below:

NOTE: Not more than 2 corners, all in the same town and range, may be recorded on this certificate.


A. Description of original monument and accessories and/or subsequent restoration:

- G-4: Cor. common to Sec. 9 & 10, T28N-R8W
 1850, GLO resurvey, used cor., set post, Beech 12", N35E,, 25, Beech 18", S52w, 48
 3-8-02, W.S. Merrill, Co. Surveyor, noted corner., no accessories
 12-8-08, W.S. Merrill, notes cor., w/accessories
 6-55, G.A. Shadko, fd 1 1/2" drain pipe 1' long w/couple, no accessories
 5-76, A.L. Dragoo, notes cor., set angle iron at old fence int., no accessories, Lib 1 Pg 907
 8-12-87, J.A. Ray, fd 1 1/2"x 1 1/2" angle iron, w/accessories, Lib 3 Pg 146

B. Description of corner evidence found and/or method applied in restoring or reestablishing corner:

- G-4: Cor. common to Sec. 9 & 10, T28N-R8W
 Fd. 1 1/2" pipe with coupling 1' long. Drove 5/8" by 36" rebar inside of pipe with standard County Monument. No GLO witnesses were fd. The Kalkaska Co. Peer group approved & accepted the above monument as a careful and faithful reestablishment of the position of the original corner.

Ratified by Peer Group
P.A. 345 - 1990 Kalkaska County
 Chairman Eugene Farrier
 Date 1-29-90

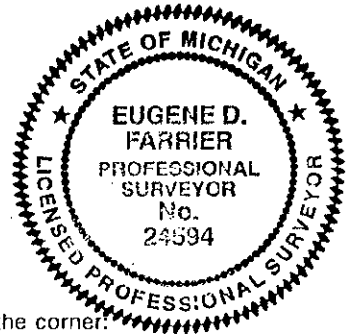

C. Description of monument for corner and accessories established to perpetuate locating the position of the corner:

- G-4: Cor. common to Sec. 9 & 10, T28N-R8W
 Fd. 1 1/2" pipe with coupling 1' long. Drove 5/8" by 36" rebar inside of pipe with standard County Monument.
 Fd. Nail N65W 17" Oak, 6.10'
 Fd. Nail N12E 5" Oak, 19.02'
 Fd. nail N81E 5" Maple, 14.33'
 Fd. Nail S15W, 4" Ironwood, 19.79'
 Fd 1/2" Ir & Cap (13030) S78E, 0.46'

Signed by Eugene Farrier
 Surveyor's Michigan License No. 24594

Date 2-3-98



3004807
 Page: 1 of 1
 02/04/98 11:22A
 LB: 5 PG: 211