

**SURVEY & REMONUMENTATION**

MAY 10 1999

KALKASKA COUNTY, MICHIGAN RECEIVED

1994 DEC 23 AM 9:31

SECTION

**LAND CORNER RECORDATION CERTIFICATE**  
**Filing Requirement of Act 74, Mich. P.A. 1970**

*Jean Hall*  
 REG. OF DEEDS

corners in

KALKASKA (County)	Located In:	Corner Code #/
1994 REMONUMENTATION		
Public Land Survey	T 28N R 8W	G-6
	T _____ R _____	_____
	T _____ R _____	_____
	T _____ R _____	_____
Property Controlling in Section	S _____ T _____ R _____	_____
Miscellaneous Property in Sec.	S _____ T _____ R _____	_____

Register of Deeds Stamp & File Number

Lot No. \_\_\_\_\_, Recorded Plat \_\_\_\_\_

Private Claims \_\_\_\_\_

	A	B	C	D	E	F	G	H	I	J	K	L	M
2	6	5	4	3	2								
3													
4	7	8	9	10	11	12							
5													
6	18	17	16	15	14	13							
7													
8	19	20	21	22	23	24							
9													
10	30	29	28	27	26	25							
11													
12	31	32	33	34	35	36							
13													

EUGENE FARRIER, in a field survey on Nov. 12, 1994, hereby certify that under requirements of P.A. 74, Michigan P.A. of 1970, the corner points mentioned in lines 1 and 2 above were in conformance with regulations and rules therefore as required in the current manual of survey instructions of the United States Department of the Interior, Bureau of Land Management or by a decree of a Court of Law and/or that the corner points mentioned in lines 3, 4 and 5 above were in conformance with the rules of the Michigan Board of Land Surveyors or by a Decree of a Court of Law; established, re-established, monumented, re-monumented, recovered, found as recorded below:

**NOTE: Not more than 4 corners, all in the same town and range, may be recorded on this certificate.**

Description of original monument and accessories and/or subsequent restoration:

G-6: Cor. common to Sec. 15 & 16, T28N-R8W.  
 1850 GLO re-survey: set post, Beech 5" S54W, 27, Beech 5" N54E, 20  
 7-25-00, Unknown Co Surv., fd orig. wit., & set stakes w/new witnesses  
 7-02, W.S. Merrill, set iron stakes at cor., no accessories  
 7-10 to 8-8-02, W.S. Merrill, noted cor. several times in notes and Rec. of Sur. of Subdivision, no accessories  
 2-72 to 8-91, Certificates of Survey, all fd 1/2" iron pipe, R.C. Dunn (Lib 1 Pg's 178 & 196, Lib D Pg 75, Lib 136 Pg 422), A.L. Dragoo (Lib 2 Pg 104), J.L. Schwardt (Lib 2 Pg 857), E. Farrier (notes cor.)


Description of corner evidence found and/or method applied in restoring or reestablishing corner:

G-6: Cor. common to Sec. 15 & 16, T28N-R8W.  
 Fd 1/2" iron in C/L Wilhelm Rd. Pulled & replaced with 5/8" x 18" rebar with brass cap 0.3' below bit road surface. No GLO witness.  
 On 12-20-94 the Kalkaska Co. peer group approved the above monument as a careful and faithful reestablishment of the position of the original corner.

Ratified by Peer Group  
 P.A. 345 - 1990 Kalkaska County  
 Chairman *[Signature]*  
 Date 12-20-94

Description of monument for corner and accessories established to perpetuate locating the position of the corner:

G-6: Cor. common to Sec. 15 & 16, T28N-R8W.  
 Fd 1/2" iron in C/L Wilhelm Rd. Pulled & replaced with 5/8" x 18" rebar with brass cap 0.3' below bit road surface.  
 Fd nail P. Pole N03W, 33.51'  
 Fd nail 10" R. Pine N50E, 69.67'  
 Fd nail Service Pole S01W, 33.41'  
 Fd nail 12" R. Pine N44W, 76.22

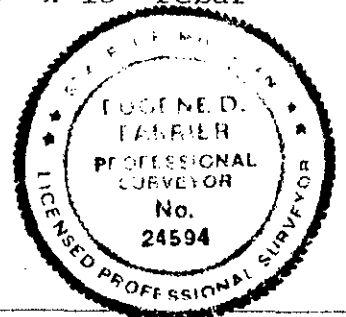

Recorded by *[Signature]*  
 Surveyor's Michigan License No. 24594

Date 12-22-94