

SURVEY & REMONUMENTATION

MAY 10 1999

KALKASKA COUNTY, MICHIGAN RECEIVED

SECTION

LAND CORNER RECORDATION CERTIFICATE

1994 DEC 23 AM 9:31

Filing Requirement of Act 74, Mich. P.A. 1970

Joan Hall
REG. OF DEEDS

corners in

KALKASKA (County)	Located In:	Corner Code #
1994 REMONUMENTATION		
Public Land Survey	T 28N R 8W	G-7
	T R	
	T R	
	T R	
Property Controlling in Section	S T R	
Miscellaneous	S T R	
Property in Sec.	S T R	

Register of Deeds Stamp & File Number

Lot No. _____, Recorded Plat _____
Private Claims _____

	A	B	C	D	E	F	G	H	I	J	K	L	M
2	6		5		4		3		2		1		
3													
4	7		8		9		10		11		12		
5													
6	18		17		16		15		14		13		
7													
8	19		20		21		22		23		24		
9													
10	30		29		28		27		26		25		
11													
12	31		32		33		34		35		36		
13													

EUGENE FARRIER, in a field survey on Nov. 12, 1994, hereby certify that under requirements of P.A. 74, Michigan P.A. of 1970, the corner points mentioned lines 1 and 2 above were in conformance with regulations and rules therefore as required in the rent manual of survey instructions of the United States Department of the Interior, Bureau of Land Management or by a decree of a Court of Law and/or that the corner points mentioned in lines 3, 4 and 5 above were in conformance with the rules of the Michigan Board of Land Surveyors or by a Decree of a Court of Law; established, re-established, monumented, re-monumented, recovered, found as pressed below:

NOTE: Not more than 4 corners, all in the same town and range, may be recorded on this certificate.

Description of original monument and accessories and/or subsequent restoration:

G-7: Cor. common to Sec. 15, 16, 21 & 22, T28N-R8W.
1850 GLO re-survey: set post, Beech 20" N50E, 53, Beech 18" S48W, 23
7-25-00, Unknown Co Surv., fd cor. w/witnesses
7-02, W.S. Merrill, set iron stakes at cor., no accessories
7-02 to 4-04, W.S. Merrill, noted cor. several times in notes and Rec. of Sur. of Subdivision, no accessories
6-8-73, LCRC(J.H. Granger), fd 1 1/2" pipe, w/accessories, Lib1 Pg 235
3-74 to 2-79, Certificates of Survey, all fd 1 1/2" pipe, G.F.
DeLaMeter(Lib 1 Pg's 493, 516 & 517), A.L. Dragoo(Lib 2 Pg 104), G. Fraser & Assoc(noted cor. sev. times)


Description of corner evidence found and/or method applied in restoring or reestablishing corner:

G-7: Cor. common to Sec. 15, 16, 21 & 22, T28N-R8W.
Fd 1 1/2" iron pipe 17' S. of 2-track. Pulled & replaced with 5/8" x 36" re-bar w/brass cap 0.6' below grade. No GLO witnesses were fd
On 12-20-94 the Kalkaska Co. peer group approved the above monument as a careful and faithful reestablishment of the position of the original corner.

Ratified by Peer Group
P.A. 345 - 1990 Kalkaska County
Chairman *[Signature]*
Date 12-20-94

Description of monument for corner and accessories established to perpetuate locating the position of the corner:

G-7: Cor. common to Sec. 15, 16, 21, & 22, T28N-R8W.
Fd 1 1/2" iron pipe 17' S. of 2-track. Pulled & replaced with 5/8" x 36" re-bar w/brass ca[0.6' below grade. No GLO witnesses were fd
Fd nail 14" Maple, S63W, 14.53'
Fd nail 8" Maple, S48E, 13.55'
Fd nail 12" R. Pine, N27E, 42.69'
Fd nail 6" Maple, S40W, 11.94'

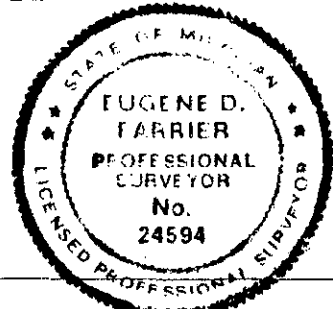

Surveyed by *[Signature]*
Surveyor's Michigan License No. 24594

Date 12-22-94