

SURVEY &
REMONUMENTATION

JUL 02 1999

KALKASKA COUNTY, MICHIGAN
RECEIVED

1994 DEC 23 AM 9:31

SECTION

LAND CORNER RECORDATION CERTIFICATE

Filing Requirement of Act 74, Mich. P.A. 1970

For corners in

Jean Hall
REG. OF DEEDS

KALKASKA (County)	Located In:	Corner Code -#
1994 REMONUMENTATION		
1. Public Land Survey	T 28N R 8W	G-8
	T ___ R ___	_____
	T ___ R ___	_____
	T ___ R ___	_____
2. Property Controlling in Section	S ___ T ___ R ___	_____
	S ___ T ___ R ___	_____
3. Miscellaneous Property in Sec.	S ___ T ___ R ___	_____
	S ___ T ___ R ___	_____

Register of Deeds Stamp & File Number

4. Lot No. _____, Recorded Plat _____
5. Private Claims _____

	A	B	C	D	E	F	G	H	I	J	K	L	M
2	6		5		4		3		2		1		
3													
4	7		8		9		10		11		12		
5													
6	18		17		16		15		14		13		
7													
8	19		20		21		22		23		24		
9													
10	30		29		28		27		26		25		
11													
12	31		32		33		34		35		36		
13													

I, EUGENE FARRIER, in a field survey on Nov. 12, 1994, do hereby certify that under requirements of P.A. 74, Michigan P.A. of 1970, the corner points mentioned in lines 1 and 2 above were in conformance with regulations and rules therefore as required in the current manual of survey instructions of the United States Department of the Interior, Bureau of Land Management or by a decree of a Court of Law and/or that the corner points mentioned in lines 3, 4 and 5 above were in conformance with the rules of the Michigan Board of Land Surveyors or by a Decree of a Court of Law; established, re-established, monumented, re-monumented, recovered, found as expressed below:

NOTE: Not more than 4 corners, all in the same town and range, may be recorded on this certificate.

A. Description of original monument and accessories and/or subsequent restoration:

G-8: Cor. common to Sec. 21 & 22, T28N-R8W.
1850 GLO re-survey: set post, Beech 8" N23W, 16, Beech 14" S34W, 58
6-6-1876, D.E. McVee (Co. Suevyor), noted cor., no accessories
6-3-1882, E. Mosher, noted cor. no accessories
4-26-04, W.S. Merrill, noted stone cor. in notes, no accessories
1904, W.S. Merrill, noted stone cor. 3 indivd. times in rec. of surveys, no accessories
2-13 & 14-79, Gourdie Fraser & Assoc., noted cor., no accessories
11-12-87, E. Farrier, fd 1/2" rerod in fences S & W, w/accessories

B. Description of corner evidence found and/or method applied in restoring or reestablishing corner:


G-8: Cor. common to Sec. 21 & 22, T28N-R8W.
Fd 1/2" x 18" re-bar in fence line W. & S. Pulled & replaced with 5/8" x 36" re-bar w/alu. cap 0.3' below ground surface. No GLO witnesses were found.
On 12-20-94 the Kalkaska Co. peer group approved the above monument as a careful and faithful reestablishment of the position of the original corner.

Ratified by Peer Group
P.A. 345 - 1990 Kalkaska County

Chairman *Eugene Farrier*
Date 12-20-94

C. Description of monument for corner and accessories established to perpetuate locating the position of the corner:

G-8: Cor. common to Sec. 21, & 22, T28N-R8W.
Fd 1/2" x 18" re-bar in fence line W. & S. Pulled & replaced with 5/8" x 36" re-bar w/ alu. cap 0.3 below ground surface.
Fd Spk N60W, 8" Cherry, 25.98
Fd Spk S38W, 10" R. Pine, 51.83
Fd Spk S13E, 18" W. Pine, 14.18
Fd Spk S70E, 8" R. Pine, 12.48

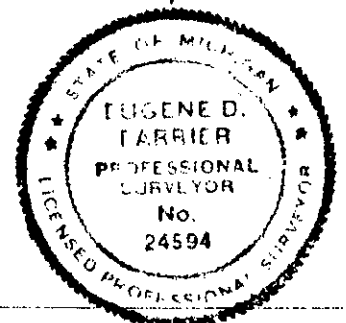

Signed by *Eugene Farrier*
Surveyor's Michigan License No. 24594

Date 12-22-94