

**SURVEY &
REMONUMENTATION**

MAY 10 1999

KALKASKA COUNTY, MICHIGAN
RECEIVED

1994 DEC 23 AM 9:31

LAND CORNER RECORDATION CERTIFICATE
Filing Requirement of Act 74, Mich. P.A. 1970

SECTION

corners in

<u>KALKASKA</u> (County)	Located In:	Corner Code #
1994 REMONUMENTATION		
Public Land Survey	T <u>28N</u> R <u>8W</u>	<u>G-9</u>
	T _____ R _____	_____
	T _____ R _____	_____
	T _____ R _____	_____
Property Controlling	S _____ T _____ R _____	_____
in Section	S _____ T _____ R _____	_____
Miscellaneous	S _____ T _____ R _____	_____
Property in Sec.	S _____ T _____ R _____	_____

Jean Hall
REG. OF DEEDS

Register of Deeds Stamp & File Number

Lot No. _____, Recorded Plat _____
Private Claims _____

	A	B	C	D	E	F	G	H	I	J	K	L	M
2	6	5	4	3	2	1							
3													
4	7	8	9	10	11	12							
5													
6	18	17	16	15	14	13							
7													
8	19	20	21	22	23	24							
9													
10	30	29	28	27	26	25							
11													
12	31	32	33	34	35	36							
13													

EUGENE FARRIER, in a field survey on Nov. 12, 1994,
hereby certify that under requirements of P.A. 74, Michigan P.A. of 1970, the corner points mentioned
lines 1 and 2 above were in conformance with regulations and rules therefore as required in the
current manual of survey instructions of the United States Department of the Interior, Bureau of Land
Management or by a decree of a Court of Law and/or that the corner points mentioned in lines 3, 4 and 5
above were in conformance with the rules of the Michigan Board of Land Surveyors or by a Decree of a
Court of Law; established, re-established, monumented, re-monumented, recovered, found as
expressed below:

**NOTE: Not more than 4 corners, all in the same town and range, may be recorded
on this certificate.**

Description of original monument and accessories and/or subsequent restoration:

G-9: Cor. common to Sec. 21, 22, 27 & 28, T28N-R8W.
1850 GLO re-survey: set post, Beech 8" S68E, 20, Beech 8" N24W, 37
1-6 & 6-15-1876, D.E. McVee (Co. Surveyor), noted cor., no accessories
6-3-1882 & 6-1884 & 9-1884, E. Mosher, noted cor. no accessories
1902-1915, W.S. Merrill, noted cor. several times, occasionally as a
stone cor., no accessories
6-8-73, LCRC (J.H. Granger), fd 1 1/2" iron, w/accessories
2-13 & 14-79, Gourdie Fraser & Assoc., noted cor., no accessories
4-6-81, E. Farrier, fd 1 1/4" pipe, w/accessories
3-1-83, E. Farrier, fd 1 1/4" pipe, no accessories, Lib 2, Pg 759
4-15-86, LCRC (E. Farrier), fd 1 1/4" pipe, w/accessories, Lib 2 Pg 298
11-12-87, E. Farrier, fd 1 1/4" pipe, w/accessories
5-15-91, P.D. Case, fd 1 1/4" pipe, w/accessories

Description of corner evidence found and/or method applied in restoring or reestablishing corner:

G-9: Cor. common to Sec. 21, 22, 27 & 28, T28N-R8W.
Fd 1 1/4" pipe 8.4' W. of C/L Old Rapid City Rd. on tree line. Pulled &
replace with 5/8" x 36" re-bar w/alu. cap 0.5 below ground surface. No
GLO witnesses were fd.
On 12-20-94 the Kalkaska Co. peer group approved the above monument as a
careful and faithful reestablishment of the position of the original
corner.

Description of monument for corner and accessories established to perpetuate locating the position of the corner:


G-9: Cor. common to Sec. 21, 22, 27 & 28, T28N-R8W.
Fd 1 1/4" pipe 8.4' W. of C/L Old Rapid City Rd. on tree line. Pulled &
replace with 5/8" x 36" re-bar w/alu. cap 0.5 below ground surface.
Set nail & tag S07E, 8" Cherry, 114.63'
Set nail & tag S15W, 40" Tw. Maple, 92.90'
Set nail & tag S45W, 5" W. Pine, 29.78'
Set nail & tag N86W, 24" Maple, 26.03'
Fd Iron & Cap 28417, 30079, West 33.00'.

Ratified by Peer Group

P.A. 345-1990 Kalkaska County

Chairman *Eugene Farrier*

Date 12-20-94

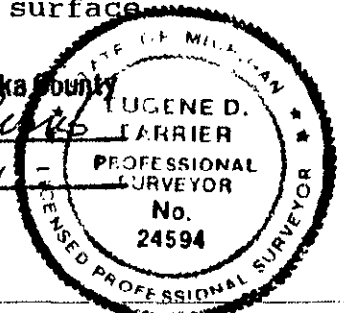

Surveyed by *Eugene Farrier*
Surveyor's Michigan License No. 24594

Date 12-22-94