

**SURVEY & REMONUMENTATION**

MAY 10 1999

KALKASKA COUNTY, MICHIGAN RECEIVED

1994 DEC 23 AM 9:31

**SECTION AND CORNER RECORDATION CERTIFICATE**

Filing Requirement of Act 74, Mich. P.A. 1970

corners in

<u>KALKASKA</u> (County)	Located In:	Corner Code #/
1994 REMONUMENTATION		
Public Land Survey	T <u>28N</u> R <u>8W</u>	<u>G-13</u>
	T _____ R _____	_____
	T _____ R _____	_____
	T _____ R _____	_____
Property Controlling	S _____ T _____ R _____	_____
In Section	S _____ T _____ R _____	_____
Miscellaneous	S _____ T _____ R _____	_____
Property in Sec.	S _____ T _____ R _____	_____

*Jean Hall*  
REG. OF DEEDS

Register of Deeds Stamp & File Number

Lot No. \_\_\_\_\_, Recorded Plat \_\_\_\_\_  
Private Claims \_\_\_\_\_

	A	B	C	D	E	F	G	H	I	J	K	L	M
2	6	5	4	3	2	1							
3													
4	7	8	9	10	11	12							
5													
6	18	17	16	15	14	13							
7													
8	19	20	21	22	23	24							
9													
10	30	29	28	27	26	25							
11													
12	31	32	33	34	35	36							
13													

EUGENE FARRIER, in a field survey on Nov. 12, 1994, hereby certify that under requirements of P.A. 74, Michigan P.A. of 1970, the corner points mentioned lines 1 and 2 above were in conformance with regulations and rules therefore as required in the recent manual of survey instructions of the United States Department of the Interior, Bureau of Land Management or by a decree of a Court of Law and/or that the corner points mentioned in lines 3, 4 and 5 above were in conformance with the rules of the Michigan Board of Land Surveyors or by a Decree of a Court of Law; established, re-established, monumented, re-monumented, recovered, found as pressed below:

**NOTE: Not more than 4 corners, all in the same town and range, may be recorded on this certificate.**

Description of original monument and accessories and/or subsequent restoration:

G-13: Cor. common to Sec. 33 & 34, T28N-R8W, Clearwater Twp., Sec. 3 & 4, T27N-R8W, W. Kalkaska Twp.

1850 GLO re-survey: set post, Sugar 24" S59W, 32, Sugar 28" N58W, 10, Sugar 16" N35E, 35, Sugar 6" S60E, 43.

9-27-1880, G. Alinepert, noted cor., no accessories

8-11-02, W.S. Merrill, noted cor., no accessories

1906 & 1907 W.S. Merrill, establish cor. at proport. dist., w/access.

1909, W.S. Merrill, noted iron stakes set at cor, no/accessories

6-67, Consumers Power, fd state Mon., w/access.

1-5-77, LCRC(H.L.Fluharty), fd 4" dia. brass cap, w/access., Lib 2 Pg 5

9-76 to 12-88, Certificates of Survey, all fd 4" dia. brass cap, H.L.

Fluharty (Lib 2 Pg 622, Lib 1 Pg 952), G.Fraser(noted cor. w/witnesses),

T.J. Mueller(Lib 2 Pg 318), A.L. Drago(Lib 2 Pg's 493, 859), E. Farrier

(fd cor. w/witness), J.L. Schwandt(Lib 2 Pg 678), N.B. DeYoung(fd cor.

w/witness), Kalkaska Co Rd Comm( fd cor. w/witness), J.J. Wible(Lib 3 Pg

140), B.M. Jones(Lib 3 Pg 285)

6-12-90, E. Farrier, fd DNR Mon., w/accessories

5-13-94, E. Farrier, fd 1/2" iron rod , w/access

Ratified by Peer Group  
P.A. 345-1990 Kalkaska County

Chairman *[Signature]*  
Date 12-20-94

Description of corner evidence found and/or method applied in restoring or reestablishing corner:

G-13: Cor. common to Sec. 33 & 34, T28N-R8W, Clearwater Twp., Sec. 3 & 4, T27N-R8W, W. Kalkaska Twp.

Fd 1/2" re-bar 6" long & 1" iron pipe w/brass cap. Pulled & replaced with 5/8" x 36" re-bar w/brass cap in C.L. Townline Rd. 0.7 below rd surface. No GLO witness were fd.

On 12-20-94 the Kalkaska Co. peer group approved the above monument as a careful and faithful reestablishment of the position of the original corner.

Description of monument for corner and accessories established to perpetuate locating the position of the corner:

G-13: Cor. common to Sec. 33 & 34, T28N-R8W, Clearwater Twp., Sec. 3 & 4, Y27N-R8W, W. Kalkaska Twp.

Fd 1/2" re-bar 6" long & 1" iron pipe w/brass cap. Pulled & replaced with 5/8" x 36" re-bar w/brass cap in C.L. Townline Rd. 0.7 below rd surface.

Fd due North I.C. #13030, 33.00'

Fd nail N45E, 10" Maple, 49.83'

Fd nail S42E, 5" I. wood, 36.63'


Fd nail S., 10" Maple, 23.16'

Fd nail N14W, 8" Maple, 29.17'

Drawn by *[Signature]*

Date 12-22-94

Surveyor's Michigan License No. 24594

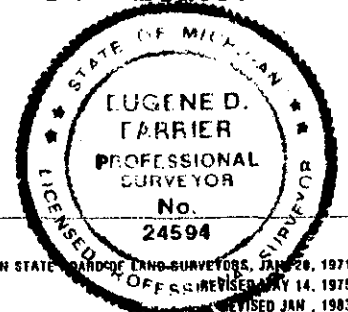

FORM APPROVED BY MICHIGAN STATE BOARD OF LAND SURVEYORS, JAN 20, 1971  
OFFICE REVISOR MAY 14, 1975  
REVISED JAN. 1983