

**SURVEY &
REMONUMENTATION**

MAY 10 1999

KALKASKA COUNTY, MICHIGAN
RECEIVED

1994 DEC 23 AM 9:32

LAND CORNER RECORDATION CERTIFICATE
Filing Requirement of Act 74, Mich. P.A. 1970

SECTION

corners in

Jean Hall
REG. OF DEEDS

KALKASKA (County)	Located In:	Corner Code ##
1994 REMONUMENTATION		
Public Land Survey	T 28N R 8W	I-13
	T R	
	T R	
	T R	
Property Controlling in Section	S T R	
Miscellaneous	S T R	
Property in Sec.	S T R	

Register of Deeds Stamp & File Number

Lot No. _____, Recorded Plat _____
Private Claims _____

	A	B	C	D	E	F	G	H	I	J	K	L	M
2	6	5	4	3	2	1							
3													
4	7	8	9	10	11	12							
5													
6	18	17	16	15	14	13							
7													
8	19	20	21	22	23	24							
9													
10	30	29	28	27	26	25							
11													
12	31	32	33	34	35	36							
13													

EUGENE FARRIER, in a field survey on Nov. 12, 1994, hereby certify that under requirements of P.A. 74, Michigan P.A. of 1970, the corner points mentioned in lines 1 and 2 above were in conformance with regulations and rules therefore as required in the recent manual of survey instructions of the United States Department of the Interior, Bureau of Land Management or by a decree of a Court of Law and/or that the corner points mentioned in lines 3, 4 and 5 above were in conformance with the rules of the Michigan Board of Land Surveyors or by a Decree of a Court of Law; established, re-established, monumented, re-monumented, recovered, found as assessed below:

NOTE: Not more than 4 corners, all in the same town and range, may be recorded on this certificate.

Description of original monument and accessories and/or subsequent restoration:

I-13: Cor. common to Sec. 34 & 35, T28N-R8W, Clearwater Twp, Sec. 2 & 3 T27N-R8W, W. Kalkaska Twp.
1850 GLO re-survey: set post, Hemlock 14", S41W, 18, Sugar 10", N62W, 23, Sugar 12", N28E, 38, Beech 12", S51E, 14
8-02 & 4-14, W.S. Merrill, noted cor., no accessories
6-67, Consumers Power, notes cor., no access.
1-5-77, LCRC(H.L. Fluharty), fd 1/2" iron, w/accessories, Lib 2 Pg 5
8-83, J.F. Korr, fd bolt spike & replaced w/1/2" iron rod, w/access., Lib 2 Pg 791.
4-15-87, B.M. Jones, fd 1/2" iron, w/accessories, Lib 3 Pg 107

Description of corner evidence found and/or method applied in restoring or reestablishing corner:


I-13: Cor. common to Sec. 34 & 35, T28N-R8W, Clearwater Twp, Sec. 2 & 3 T27N-R8W, W. Kalkaska Twp.
Fd 5/8" re-bar w/cap #12581 in SE cor. of Rd int. Sec. Removed cap, left re-bar, placed alu. remon cap 0.4 below ground surface. No GLO witness were fd.
On 12-20-94 the Kalkaska Co. peer group approved the above monument as the best available evidence of the position of the original corner.

Ratified by Peer Group
P.A. 345 - 1990 Kalkaska County

Chairman *Eugene Farrier*
Date 12-20-94

Description of monument for corner and accessories established to perpetuate locating position of the corner:

I-13: Cor. common to Sec. 34 & 35, T28N-R8W, Clearwater Twp, Sec. 2 & 3 T27N-R8W, W. Kalkaska Twp.
Fd 5/8" re-bar w/cap #12581 in SE cor. of rd int. sec. Removed cap, left re-bar, placed alu. remon cap 0.4 below ground surface.
Reset nail N08E, 16" Maple, 24.80'
Fd nail S30W, Triple Maple, 54.35'
Fd nail S85W, 12" Maple, 50.39'
Fd nail N54W, 14" Maple, 49.55'

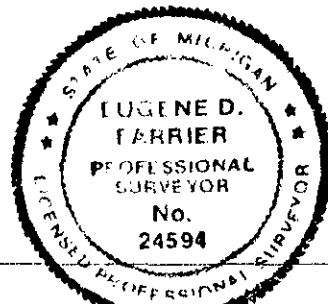

Surveyed by *Eugene Farrier*
Surveyor's Michigan License No. 24594

Date 12-22-94