

FEB 18 1999

154-155

Liber 00003 Page 0023

SECTION

LAND CORNER RECORDATION CERTIFICATE ANTRIM COUNTY MI.
Filing Requirement of Act 74, Mich. P.A. 1970 Register of Deeds
Recorded

For corners in

MILTON

<u>Antrim</u> (County)	Located in:	Corner Code #
1. Public Land Survey	Sec 35 T29NR 9W	J-13
	Sec. 2 T28NR 9W	J-1 ✓
	T R	
	T R	
2. Property Controlling in Section	S T R	
	S T R	
3. Miscellaneous Property in Sec.	S T R	
	S T R	

12-15-1998 10:17:26

Wanda R. Conway
REGISTER OF DEEDS

Register of Deeds Stamp & File Number

4. Lot No. _____, Recorded Plat _____
5. Private Claims _____

I, Terry B. Smith, in a field survey on 12-10, 1998 do hereby state that under requirements of P.A. 74, Michigan P.A. of 1970, the corner points mentioned in lines 1 and 2 above were in conformance with regulations and rules therefore as required in the current manual of survey instructions of the United States Department of the Interior, Bureau of Land Management or by a decree of a Court of Law and /or that the corner points mentioned in lines 3, 4 and 5 above were in conformance with the rules of the Michigan Board of Land Surveyors or by a Decree of a Court of Law; established, re-established, monumented, recovered, found as expressed below:

NOTE: Not more than 2 corners, all in the same town and range, may be recorded on this certificate.

A	B	C	D	E	F	G	H	I	J	K	L	M
1												
2	6	5	4	3	2	1						
3												
4	7	8	9	10	11	12						
5												
6	18	17	16	15	14	13						
7												
8	19	20	21	22	23	24						
9												
10	30	29	28	27	26	25						
11												
12	31	32	33	34	35	36						
13												

A. Description of original monument and accessories and/or subsequent restoration:

- GLO Circa 1983 -- no evidence found
- certificates: B. Jones 1981
- J. Fletcher 1974
- Wilcox Assoc 1993
- G. DeLaMater 1979
- W. Batzer 1977
- A. Lennox 1979

LCRC Liber 2 page 161

B. Description of corner evidence found and/or method applied in restoring or reestablishing corner:

found 1/2" steel bar & witnesses per LCRC


Ratified by peer group
in accordance with
P.O. 345
Antrim Co. Chairman

Arthur L. Lennox

Arthur L. Lennox
Nov. 18, 1998

C. Description of monument for corner and accessories established to perpetuate locating the position of the corner:

- Set Antrim county Monument & highway box
- UP N40E 80.71
- spk. in basswood clump S15E 30.75
- 12" Oak S25W 69.96
- 4" Oak N25W 28.86

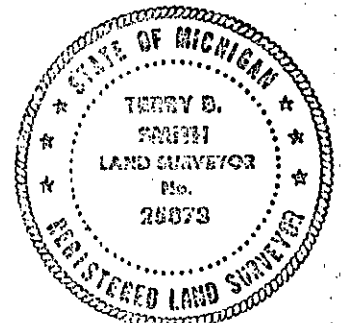

Signed by Terry B. Smith
Surveyor's Michigan License No. 25873

Date DEC. 14, 1998