

FEB 18 1999

156

Liber 00003 Page 0022
ANTRIM COUNTY MI.
Register of Deeds
Recorded

SECTION

LAND CORNER RECORDATION CERTIFICATE
Filing Requirement of Act 74, Mich. P.A. 1970

For corners in

MILTON

Antrim
(County)

Located In:

Corner Code #

- 1. Public Land Survey Sec 2 T 28NR 9W K-2
T R
T R
T R
- 2. Property Controlling in Section S T R
S T R
- 3. Miscellaneous Property in Sec. S T R
S T R

12-15-1998 10:17:16

Wanda R. Conway
REGISTER OF DEEDS

Register of Deeds Stamp & File Number

- 4. Lot No. _____, Recorded Plat _____
- 5. Private Claims _____

| | | | | | | | | | | | | | |
|----|----|---|----|---|----|---|----|---|----|---|----|---|---|
| | A | B | C | D | E | F | G | H | I | J | K | L | M |
| 1 | | | | | | | | | | | | | |
| 2 | 6 | | 5 | | 4 | | 3 | | 2 | | 1 | | |
| 3 | | | | | | | | | | | | | |
| 4 | 7 | | 8 | | 9 | | 10 | | 11 | | 12 | | |
| 5 | | | | | | | | | | | | | |
| 6 | 18 | | 17 | | 16 | | 15 | | 14 | | 13 | | |
| 7 | | | | | | | | | | | | | |
| 8 | 19 | | 20 | | 21 | | 22 | | 23 | | 24 | | |
| 9 | | | | | | | | | | | | | |
| 10 | 30 | | 29 | | 28 | | 27 | | 26 | | 25 | | |
| 11 | | | | | | | | | | | | | |
| 12 | 31 | | 32 | | 33 | | 34 | | 35 | | 36 | | |
| 13 | | | | | | | | | | | | | |

I, Terry B. Smith, in a field survey on 12-10-9819 do hereby state that under requirements of P.A. 74, Michigan P.A. of 1970, the corner points mentioned in lines 1 and 2 above were in conformance with regulations and rules therefore as required in the current manual of survey instructions of the United States Department of the Interior, Bureau of Land Management or by a decree of a Court of Law and/or that the corner points mentioned in lines 3, 4 and 5 above were in conformance with the rules of the Michigan Board of Land Surveyors or by a Decree of a Court of Law; established, re-established, monumented, recovered, found as expressed below:

NOTE: Not more than 2 corners, all in the same town and range, may be recorded on this certificate.

A. Description of original monument and accessories and/or subsequent restoration:

GLO circa 1853 -- no evidence
County Surveyor's notes circa 1901
certificate J. Fletcher 1975
LCRC Liber 219 pg. 580 --1974LCRC
LCRC Liber 2 pg. 160 1993

Ratified by peer group
in accordance with
P.O. 345
Antrim Co. Chairman


Arthur L. Lennox
Arthur L. Lennox
Nov. 18, 1998

B. Description of corner evidence found and/or method applied in restoring or reestablishing corner:

found 1/2" steel bar & witnesses per existing LCRC & certificates

C. Description of monument for corner and accessories established to perpetuate locating the position of the corner:

Set Antrim County Monument & highway box
10" R. Pine N85E 158.09
10" S. Pine S20E 79.62
16" Maple S55W 53.46
UP N05W 261.79

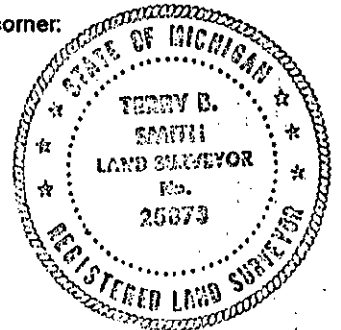

Signed by *Terry B. Smith*
Surveyor's Michigan License No. 25873

Date DEC. 14, 1998