

FEB 10 1999

172

Liber 00003 Page 0030

SECTION

LAND CORNER RECORDATION CERTIFICATE ANTRIM COUNTY MI. Register of Deeds Recorded

For corners in ANTRIM (County) 1998 REMONUMENTATION 1. Public Land Survey 2. Property Controlling in Section 3. Miscellaneous Property in Sec. 4. Lot No. 5. Private Claims

12-21-1998 11:36:04 Wanda R. Conway REGISTER OF DEEDS

Register of Deeds Stamp & File Number

Grid with columns A-M and rows 1-13. A dot is present in cell J3.

RICHARD J. KRAL in a field survey on November 19, 1998 do hereby state that under requirements of P.A. 74, Michigan P.A. of 1970, the corner points mentioned in lines 1 and 2 above were in conformance with regulations and rules therefore as required in the current manual of survey instructions of the United States Department of the Interior, Bureau of Land Management or by a decree of a Court of Law and /or that the corner points mentioned in lines 3, 4 and 5 above were in conformance with the rules of the Michigan Board of Land Surveyors or by a Decree of a Court of Law; established, re-established, monumented, recovered, found as expressed below:


NOTE: Not more than 2 corners, all in the same town and range, may be recorded on this certificate.

- A. Description of original monument and accessories and/or subsequent restoration: C-3: Sec. Corner Com. to Secs. 1, 2, 11 & 12, T28N-R9W, Milton Township 1852, Gov't Re-Survey, set post for corner, Lynn 8", N77°W, 36 Lks. (23.76'); W. Cedar 6", S47°E, 11 Lks. (7.26') 1929, Survey, H.L. Botsford, Co. Rd. Survey Bk. Pg 6-A shows E.line of Sec. 2, no ref. to SE cor. Sec. 2; shows fd 1 1/4" pipe for E 1/8 cor. of SE 1/4 Sec. 2 (N. of cor.) Date Unknown, Witness Co. Rd. Survey Bk., Pg. 1, by unkn, cor. desc. unkn; N. end of cmp., NE, 28.15'; S. end cmp., SE, 24.35' 1959, Survey; M.C. Feindt, not rec.; shows cor. but no desc. or acc. 1961, Plat of Elkridge Woods, rec. in Lib. 2 of plats, Pg. 117, begins 3035', N89°50'W & 745', N0°10'E, of SE cor. Sec. 2 1967, Survey, M.C. Feindt, not rec.; shows cor. 636.75' South of survey in Sec. 1, & 1316.50' West of survey in Sec. 12 1974, LCRC, J.L. Fletcher, rec. in Lib. 1, Pg. 185; & C.S. Lib. 220, Pg. 707, set 1/2" iron pipe by Doubling over fd. 1/8 cor. r.o.w. iron & W 1/4 cor. Sec. 1, nail power pole, N40°W, 93.48'; nail 10" Pine, S85°W, 36.97'; nail cor. fen. post, S45°E, 53.09'

CONTINUED ON BACK)

- B. Description of corner evidence found and/or method applied in restoring or reestablishing corner: C-3: Sec. Corner Com. to Secs. 1, 2, 11 & 12, T28N-R9W, Milton Township fd. 1/2" iron pipe & cap # ? Pulled & replaced with Antrim County monument (Berntsten Model G-1 [30" Piston] with G-2 Cap) in mon. box fd. road sign post N48°E, 44.65' (R.44.6') fd. nail in NE side r.o.w. fen. cor E., 53.32' (R. 53.09') fd. nail in NW face r.o.w. fen. cor. S35°E, 52.89' (R. 53.08') fd. 1/2" iron rod 5'E of 2 N-S asph. S09°W, 33.00' (R. 33.00') fd. nail in NE face p. pole S54°W, 35.84' (R. 36.0') fd. nail in E. face 22" W. Pine S87°W, 35.83' (R.36.97')(R.36.15')(R.37.0') fd. iron & cap 28432, N87°W, 32.85' (R. 33.0') fd. nail in NE side p. pole N34°W, 93.50' (R.93.56')(R93.48') fd. 1" X 2", "U" iron 2.2' below asph. rd. surface opp. old fen. to West, S42°W, 4.00' No G.L.O. witnesses were found.

Ratified by peer group in accordance with P.O. 345 Antrim Co. Chairman Arthur L. Lennox Nov 19; 1998

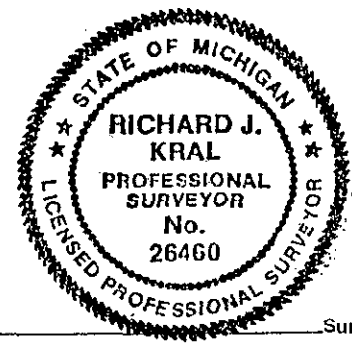

- C. Description of monument for corner and accessories established to perpetuate locating the position of the corner: C-3: Sec. Corner Com. to Secs. 1, 2, 11 & 12, T28N-R9W, Milton Township fd. 1/2" iron pipe & cap # ? Pulled & replaced with Antrim County monument (Berntsten Model G-1 [30" Piston] with G-2 Cap) in mon. box fd. road sign post N48°E, 44.65' (R.44.6') fd. nail in NE side r.o.w. fen. cor E., 53.32' (R. 53.09') fd. nail in NW face r.o.w. fen. cor. S35°E, 52.89' (R. 53.08') fd. 1/2" iron rod 5'E of 2 N-S asph. S09°W, 33.00' (R. 33.00') fd. nail in NE face p. pole S54°W, 35.84' (R. 36.0') fd. nail in E. face 22" W. Pine S87°W, 35.83' (R.36.97')(R.36.15')(R.37.0') fd. iron & cap 28432, N87°W, 32.85' (R. 33.0') fd. nail in NE side p. pole N34°W, 93.50' (R.93.56')(R93.48') fd. 1" X 2", "U" iron 2.2' below asph. rd. surface opp. old fen. to West, S42°W, 4.00'

Signed by Richard J. Kral Michigan License No. 26460

Date 12-16-98 Surveyor's

(CONTINUED FROM "A", PREVIOUS PAGE)

K-3: Sec. Corner Com. to Secs. 1, 2, 11 & 12, T28N-B9W, Milton Township

1983 & 1984, Survey by A. Lennox (Co. Surveyor) recorded in Lib. 282, Pg. 981 & Lib. 296, Pg. 432, bar # 19830; 14" W. Pine West 37.00'; fen. post, S45°W, 53.15'; U.P. N40°W, 93.50'

1988, LCRC by B.M. Jones, used a different corner position and recorded in Lib. 2, Pg. 107; fd conc. mon. & no witness; 8" W. Pine, N40°W, 41.60'; 3' rock, S70°W, 23.30' 10" Apple, S10°W, 74.60'; 8" Apple, N35°E, 67.10'

1990, Survey by N. DeYoung, not rec., fd 1/2" iron rod; 18" W. Pine, S85°W, 36.15'; cor. fen. post S45°E, 53.05'; road sign N42°E, 44.6'; p. pole, S55°W, 36.0'

1991, & 1992, Survey, N.L. Way, not rec.; fd 1/2" iron pipe, raised with iron & cap; 18" Pine, West 37.0'; fen. post S45°W, 53.0'; power pole N40°W, 93.35'; 1/2" iron rod West 33.0'


FEB 18 1999

SECTION