

FEB 16 1999

ANTRIM COUNTY MI. Register of Deeds Filed

SECTION

LAND CORNER RECORDATION CERTIFICATE Filing Requirement of Act 74, Mich. P.A. 1970

For corners in

MILTON TOWNSHIP

12-21-1998 11:39:00

ANTRIM

Located In:

Corner Code #

(County)

Manda R. Conway REGISTER OF DEEDS

1998 REMONUMENTATION

1. Public Land Survey

T 28N R 9W L-3

T R

T R

T R

2. Property Controlling in Section

S T R

S T R

3. Miscellaneous

S T R

Property in Sec.

S T R

Register of Deeds Stamp & File Number

4. Lot No. , Recorded Plat

5. Private Claims

A	B	C	D	E	F	G	H	I	J	K	L	M
1												
2	6	5	4	3	2	1						
3												
4	7	8	9	10	11	12						
5												
6	18	17	16	15	14	13						
7												
8	19	20	21	22	23	24						
9												
10	30	29	28	27	26	25						
11												
12	31	32	33	34	35	36						
13												

I, RICHARD J. KRAL, in a field survey on November 19, 1998 do hereby state that under requirements of P.A. 74, Michigan P.A. of 1970; the corner points mentioned in lines 1 and 2 above were in conformance with regulations and rules therefore as required in the current manual of survey instructions of the United States Department of the Interior, Bureau of Land Management or by a decree of a Court of Law and /or that the corner points mentioned in lines 3, 4 and 5 above were in conformance with the rules of the Michigan Board of Land Surveyors or by a Decree of a Court of Law; established, re-established, monumented, recovered, found as expressed below:

NOTE: Not more than 2 corners, all in the same town and range, may be recorded on this certificate.

A. Description of original monument and accessories and/or subsequent restoration:


L-3: 1/4 Cor. Common to Secs. 1 & 12, T28N-R9W, Milton Township
1852, Gov't re-survey, set post for cor.; Beech 4", N47°W 19 Lks. (12.54'); Beech 8" S63°E, 15 Lks. (9.90')
1891, Survey by E. Hibden (Co. Surveyor) rec. in Co. Survey Bk., Pg. 164 & 166 shows measuring into cor. no description or acc.
1966, Survey by R.E. Findorff; not recorded; 1 1/4" sq. iron at cor. r.o.w. iron, East 662.50' & South 33.0'
1967, Survey by M.C. Feindt; not recorded; shows cor. North 33.0' & East 658.25' of survey in Sec. 12.

B. Description of corner evidence found and/or method applied in restoring or reestablishing corner:

L-3: 1/4 Cor. Common to Secs. 1 & 12, T28N-R9W, Milton Township
Fd. 1/2" iron pipe, with 2 Caps # ? 1'N & 1'E of C/L road int.; 28'N & 34'W of metal r.o.w. fence line
Pulled & replaced with Antrim County monument (Berntsten Model G-1 [30" Piston] with G-2 Cap) in mon. box
Fd. nail in SE side 12" W. Pine, N43°E, 49.24'
Fd. nail & tag, Findorff & Richards in SW side power pole, S17°E, 68.45'
Fd. nail in triple Locust, N30°W, 39.33'
No G.L.O. witness were found.

C. Description of monument for corner and accessories established to perpetuate locating the position of the corner:

L-3: 1/4 Cor. Common to Secs. 1 & 12, T28N-R9W, Milton Township
Fd. 1/2" iron pipe, with 2 Caps # ? 1'N & 1'E of C/L road int.; 28'N & 34'W of metal r.o.w. fence line
Pulled & replaced with Antrim County monument (Berntsten Model G-1 [30" Piston] with G-2 Cap) in mon. box
Fd. nail in SE side 12" W. Pine, N43°E, 49.24'
Fd. nail & tag, Findorff & Richards in SW side power pole, S17°E, 68.45'
Fd. nail in triple Locust, N30°W, 39.33'
Set nail in cor. fen. post, S52°W, 54.23'

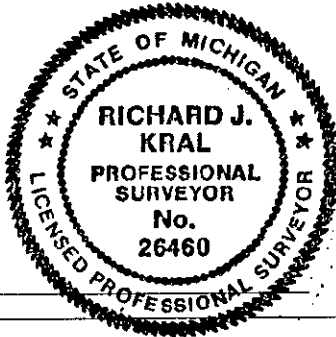

Ratified by peer group in accordance with P.O. 345 Antrim Co. Chairman

Signature of Arthur L. Lennox, dated Nov. 18, 1998

Signed by Richard J. Kral Michigan License No. 26460

Date 12-16-98 Surveyor's