

FEB 18 1999

SECTION

LAND CORNER RECORDATION CERTIFICATE  
Filing Requirement of Act 74, Mich. P.A. 1970

ANTRIM COUNTY MI.  
Register of Deeds  
Filed

For corners in

MILTON TOWNSHIP

12-21-1998 11:37:56

ANTRIM (County)

Located In:

Corner Code #

Wanda R. Conway  
REGISTER OF DEEDS

1998 REMONUMENTATION

1. Public Land Survey

T 28N R 9W

M-5 & (A-5)

T 28N R 8W

T R

T R

2. Property Controlling in Section

S T R

S T R

3. Miscellaneous Property in Sec.

S T R

S T R

Register of Deeds Stamp & File Number

4. Lot No. , Recorded Plat

5. Private Claims

	A	B	C	D	E	F	G	H	I	J	K	L	M
1													
2	6		5		4		3		2		1		
3													
4	7		8		9		10		11		12		
5													
6	18		17		16		15		14		13		
7													
8	19		20		21		22		23		24		
9													
10	30		29		28		27		26		25		
11													
12	31		32		33		34		35		36		
13													

I, RICHARD J. KRAL, in a field survey on 11-16, 1998 do hereby state that under requirements of P.A. 74, Michigan P.A. of 1970, the corner points mentioned in lines 1 and 2 above were in conformance with regulations and rules therefore as required in the current manual of survey instructions of the United States Department of the Interior, Bureau of Land Management or by a decree of a Court of Law and for that the corner points mentioned in lines 3, 4 and 5 above were in conformance with the rules of the Michigan Board of Land Surveyors or by a Decree of a Court of Law; established, re-established, monumented, recovered, found as expressed below:

NOTE: Not more than 2 corners, all in the same town and range, may be recorded on this certificate.

A. Description of original monument and accessories and/or subsequent restoration:

M-5: Sec. Cor. Common to Secs. 12 & 13, T28N-R9W, & (A-5) Secs. 7 & 8, T28N-R8W, Milton Township

(CONTINUED ON BACK)

B. Description of corner evidence found and/or method applied in restoring or reestablishing corner:


M-5: Sec. Cor. Common to Secs. 12 & 13, T28N-R9W, & (A-5) Secs. 7 & 8, T28N-R8W, Milton Township  
Fd. conc. mon w/DNR cap along side a bent 1" iron pipe & 4" X 2' conc. in pla. guard post, left DNR mon. in place  
Fd. blazed 9" Hemlock, N35°W, 16.0' (R. 16.3')  
Fd. nail in SW side 12" R. Pine, S76°E, 10.64'  
Fd. nail in North side 10" R. Pine, S56°W, 22.14'  
Fd. blazed 14" R. Pine, S47°E, 20.15' (R. 20.2')  
Fd. blazed 8" R. Pine, S77°W, 35.47' (R. 35.3')  
Fd. nail in 8" Hemlock, N05°W, 16.53'  
Fd. nail in twin 6" Hemlock, S33°W, 26.82'  
Fd. 18" W. Pine stump (blazed), S20°W, 14.55' (G.L.O.- 14.52')  
Fd. old remains of pine stump, S35°E, 9.0' (G.L.O.- 9.24')  
Fd. old remains of pine stump, N48°E, 11.8' (G.L.O.- 10.56')

C. Description of monument for corner and accessories established to perpetuate locating the position of the corner:

M-5: Sec. Cor. Common to Secs. 12 & 13, T28N-R9W, & (A-5) Secs. 7 & 8, T28N-R8W, Milton Township  
Fd. conc. mon w/DNR cap along side a bent 1" iron pipe & 4" X 2' conc. in pla. guard post, left DNR mon. in place  
Fd. blazed 9" Hemlock, N35°W, 16.0' (R. 16.3')  
Fd. nail in SW side 12" R. Pine, S76°E, 10.64'  
Fd. nail in North side 10" R. Pine, S56°W, 22.14'  
Fd. blazed 14" R. Pine, S47°E, 20.15' (R. 20.2')  
Fd. blazed 8" R. Pine, S77°W, 35.47' (R. 35.3')  
Fd. nail in 8" Hemlock, N05°W, 16.53'  
Fd. nail in twin 6" Hemlock, S33°W, 26.82'  
Fd. 18" W. Pine stump (blazed), S20°W, 14.55' (G.L.O.- 14.52')  
Set nail in 8" Hemlock, N35°W, 15.90'  
Set nail in 14" R. Pine, S47°E, 20.34'  
Set nail in 8" R. Pine, S77°W, 35.29'

Ratified by peer group  
in accordance with  
P.O. 345  
Antrim Co. Chairman  
Arthur L. Lennox  
Nov. 18, 1998

Signed by Richard J. Kral  
Michigan License No. 26460

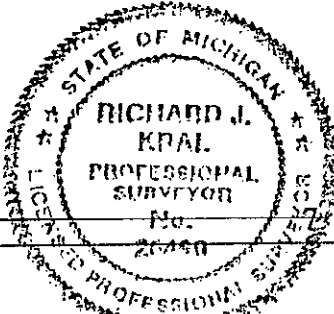

Date 12-16-98 Surveyor's

CONTINUED FROM "A", PREVIOUS PAGE)

Sec. Cor. Common to Secs. 12 & 13, T28N-R9W, & (A-5) Secs. 7 & 8, T28N-R8W, Milton Township

- Gov't Re-Survey, set post for cor. W. Pine 14", S16°W, 22 Lks. (14.52'); W. Pine 16", N87°W, 9 Lks. (5.94'); W. Pine 18", N48°E, 16 Lks. (10.56'); W. Pine 16", S35°E, 14 Lks. (9.24') top of hill, South 6.0 CH. (396.0')
- Survey by E. Hibden (Co. Surveyor) recorded in Co. Survey Bk, Pg. 166, measured West 1323.3' setting Cedar stake at South 1/8 cor. SE 1/4, Sec. 12, no. desc. or acc.
- Survey by W.S. Merrill (Kankaska Co. Surveyor) FB #31, Pg. 38; notes iron pipe at corner & found Gov't bearing trees.
- Plat of Fairmount Shores Sub., by M.C. Feindt, recorded in Lib. 2, Pg. 138, P.O.B. is a conc. mon.; South 1665' from K-5 & (A-5)
- Survey by C.F. Roser (DNR Surveyor) not recorded
- LCRC by C.F. Roser (DNR Surveyor) recorded in Lib. 1, Pg. 151; found 1" X 36" pipe & add DNR con. mon. w/ stl. fen. post; 8" R. Pine S73°W, 35.3'; 8" Hemlock, N35°W, 16.3'; 10" R. Pine, S49°E, 20.2'
- Survey by R.C. Dunn, recorded in Lib. 218, Pg. 332; fd. 1" pipe, no accessories
- Survey by L.J. Czubak, recorded in Lib. 213, Pg. 288' measured from   ?
- Survey by A. Lennox, Rec. in Lib. 212, Pg. 73; found DNR mon. ; no accessories
- Survey by Gourdie-Fraser & Assoc. not recorded, shows cor. only
- Survey by G.F. Delamater, rec. in Lib. 233, Pg. 420; shows cor. only
- Survey by G.G. Wilson, not recorded; shows corner only
- Survey by T.R. Smith, rec. in Lib. 287, Pg. 513; accessories the same as LCRC of 1972, Rec. in Lib. 1, Pg. 151.
- Survey by B.M. Jones; rec. in Lib. 310, Pg. 659; found 1" pipe, 12" R. Pine, S80°E, 10.6'; 6" Spruce N10°W, 16.64'; R. Pine, S50°W, 22.16'

SURVEY &  
RECORD RE-INITIATION

FEB 18 1999

SECTION