

MICHIGAN
DEPARTMENT OF CONSERVATION
FORESTRY DIVISION

LAND CORNER RECORD

T. 29 N. R. 5W

Antrim COUNTY


DESCRIPTION OF CORNER 1/4 corner common to sections 15-22

CORNER MONUMENT Left 1 1/2" iron bar in place, 8" below surface

DATE MONUMENT PLACED AND WITNESSED May 12, 1966

WITNESSES TO CORNER..... 6" Maple clump S 3 E 57.0'

7" Maple clump S 57 W 77.5'

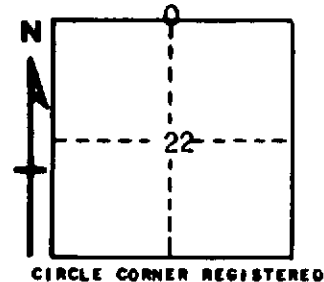

AND

DESCRIPTION IN DETAIL AS TO HOW CORNER WAS LOCATED AND IDENTIFIED OR RESTORED.

This corner was found while making a survey of the S 1/2 of this township. Found iron bar in place, probably as established in early survey by county surveyor. No U.S. evidence. Falls about 3' north of centerline.

SURVEYOR'S SEAL

SIGNED Kenneth J. Ostling DATE May 17, 1966
REGISTERED LAND SURVEYOR #10068