

MICHIGAN
DEPARTMENT OF CONSERVATION
FORESTRY DIVISION

LAND CORNER RECORD

T. 29 N.R. 5 W


Antrim COUNTY

DESCRIPTION OF CORNER Sec. corner common to sections 15-16-21-22

CORNER MONUMENT Left 3/4" pipe in place below surface

DATE MONUMENT PLACED AND WITNESSED May 12, 1966

WITNESSES TO CORNER.....

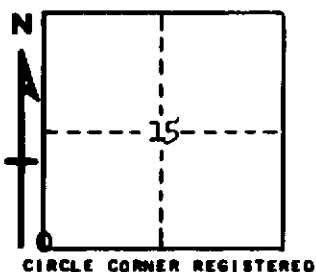

7" Maple S 1 W 32.2'

10" R. Pine N 20 E 30.1'

AND

DESCRIPTION IN DETAIL AS TO HOW CORNER WAS LOCATED AND IDENTIFIED OR RESTORED.

This corner was found while making a survey of the S $\frac{1}{2}$ of this township. Found pipe at corner probably as established in early survey by county surveyor. No record of this corner, and no U.S. evidence, but is considered best available. evidence of proper location for corner. Faces at centerline of E.-W county road and fireline north.

SURVEYOR'S SEAL

SIGNED *Kenneth J. Osting* DATE May 17, 1966
REGISTERED LAND SURVEYOR #10068