


LAND CORNER RECORDATION CERTIFICATE
Filing Requirement of Act 74, Mich. PA 1970

For Corners In: Antrim <hr/> (County)	Located In	Corner Code #
1. Public Land Survey	T _____ R _____	_____
	T _____ R _____	_____
2. Property Controlling in Section	S <u>25</u> T <u>29</u> R <u>6W</u>	<u>16</u>
	S <u>36</u> T <u>29</u> R <u>6W</u>	<u>4</u>
3. Miscellaneous Property in Section	S _____ T _____ R _____	_____
	S _____ T _____ R _____	_____
4. Lot No: _____	Recorded Plat: _____	
5. Private Claims: _____		

Register of Deeds Stamp & File Number

I, Carl T. Kiiskila, in a field survey on October 25, 2000 do hereby state that under requirements of PA 74, Michigan PA of 1970, the corner points mentioned in lines 1 and 2 above were in conformance with regulations and rules therefore as required in the current manual of survey instructions of the United States Department of the Interior, Bureau of Land Management or by a decree of a Court of Law and/or that the corner points mentioned in lines 3, 4 and 5 above were in conformance with the rules of the Michigan Board of Land Surveyors or by a Decree of a Court of Law; established, re-established, monumented, recovered, found as expressed below:

NOTE: Not more than 2 corners, all in the same town and range, may be recorded on this certificate.

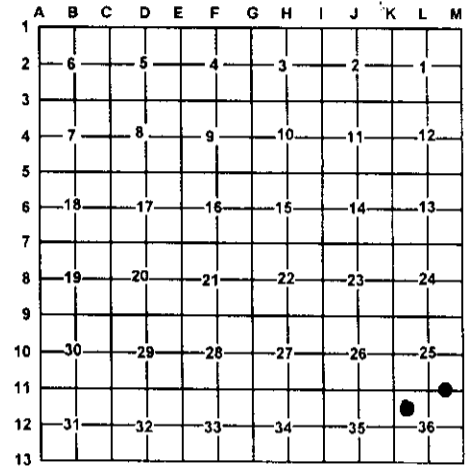

A. Description of original monument and accessories and/or subsequent restoration:

16- This corner position was not established during the original government survey.

4- This corner position was not established during the original government survey.

B. Description of corner evidence found and/or method applies in restoring or re-establishing corner:

16- Established the Southeast Corner of the Southwest Quarter of the Southeast Quarter of Section 25 as per B.L.M. instructions for the subdivision of a section.

4- Established the Southeast corner of the Northwest quarter of the Northwest quarter of section 36 as per B.L.M. instructions for the subdivision of a section.

C. Description of monument for corner and accessories established to perpetuate locating the position of the corner:

16- Set 5/8 x 32 Rerod w/PS Cap #33981
 Wit: 12" Red Pine N72°W 22.45'
 14" Elm N29°W 13.48'
 13" Red Pine S14°W 86.05'
 5" Cherry N85°E 25.19'
 Carsonite Post North 1'±
 Centerline of trail road North 40'±

4- Set 5/8" X 32" rerod with P.S. cap #33981
 Wit: 14" Basswood N17°W 65.65'
 10" Red Pine N63°W 29.33'
 4" Red Pine South 16.33'
 12" Maple S46°E 42.32'

Signed by:

Carl T. Kiiskila

Date:

4-15-02

Surveyor's Michigan License No.:

33981

