

LAND CORNER RECORDATION CERTIFICATE


Filing Requirement of Act 74, Mich. PA 1970

For Corners In: Antrim _____ (County)	Located In	Corner Code #	
1. Public Land Survey	T 29 R 6W	L-10	
	T _____ R _____	_____	
2. Property Controlling in Section	S 25 T 29 R 6W	7	
	S _____ T _____ R _____	_____	
3. Miscellaneous Property in Section	S _____ T _____ R _____	_____	
	S _____ T _____ R _____	_____	
4. Lot No: _____	Recorded Plat: _____		
5. Private Claims: _____			

Register of Deeds Stamp & File Number

I, Carl T. Kiiskila, in a field survey on October 30, 2000 do hereby state that under requirements of PA 74, Michigan PA of 1970, the corner points mentioned in lines 1 and 2 above were in conformance with regulations and rules therefore as required in the current manual of survey instructions of the United States Department of the Interior, Bureau of Land Management or by a decree of a Court of Law and/or that the corner points mentioned in lines 3, 4 and 5 above were in conformance with the rules of the Michigan Board of Land Surveyors or by a Decree of a Court of Law; established, re-established, monumented, recovered, found as expressed below:

NOTE: Not more than 2 corners, all in the same town and range, may be recorded on this certificate.

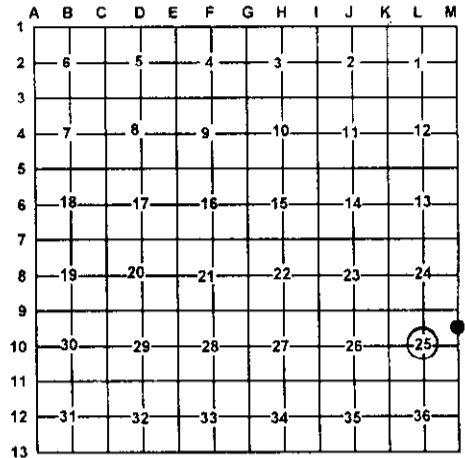

A. Description of original monument and accessories and/or subsequent restoration:

L-10 – Beryl M. Jones L.S. #23514 May 1988 Cert. of Survey L. 327 P. 729 "Set 1/2" iron" wit: S45°W 6" Maple, N47°W 6" Poplar 40.12', S80°E 6" J. Pine 17.25', S30°E 6" B. Cherry 14.62'	7 – Beryl M. Jones L.S. #23514 May 1988 Cert. of Survey L. 327 P. 729 corner found no description of found object or witnesses given.
--	---

B. Description of corner evidence found and/or method applies in restoring or re-establishing corner:

L-10 – Found 1/2 Rod w/Cap B. Jones PS #23514	7 – Found 1/2" Iron Pipe
---	--------------------------

C. Description of monument for corner and accessories established to perpetuate locating the position of the corner:

L-10 – Found 1/2" Rod with Cap B. Jones PS #23514 Wit: *8" Cherry N20°E 1.20' 4" Cherry S75°E 9.08' 4" Cherry S38°W 60.34' 6" Cherry N45°W 37.63' 4" Pipe S20°E 1.4' Carsonite Post West 1'± Ctr. E-W Trail Road South 24'±	7 – Found 1/2" Iron Pipe Wit: 8" Cherry S53°E 32.88' 8" Red Pine N85°E 34.89' 10" Red Pine N57°E 45.37' 8" Cherry S75°W 29.01' Carsonite Post West 33'± Ctr. N-S Trail Road East 5'±
--	--

* Old witnesses by other

Signed by: Carl T. Kiiskila
 Surveyor's Michigan License No.: 33981

Date: 4-15-02

