

JAN 27 2000

SECTION

LAND CORNER RECORDATION CERTIFICATE
Filing Requirement of Act 74, Mich. P.A. 1970

Liber 00003 Page 0096

For corners in

ANTRIM (County)

HELENA TOWNSHIP

Located In:

Corner Code #

1999 REMONUMENTATION

1. Public Land Survey

T 29N R 8W G-6

T R

T R

T R

2. Property Controlling in Section

S T R

S T R

3. Miscellaneous Property in Sec.

S T R

S T R

ANTRIM COUNTY MI. Register of Deeds Recorded

01-04-2000 09:53:23

Wanda R. Conway REGISTER OF DEEDS

Register of Deeds Stamp & File Number

4. Lot No. , Recorded Plat

5. Private Claims

I, RICHARD J. KRAL, in a field survey on November 16, 1999 do hereby state that under requirements of P.A. 74, Michigan P.A. of 1970, the corner points mentioned in lines 1 and 2 above were in conformance with regulations and rules therefore as required in the current manual of survey instructions of the United States Department of the Interior, Bureau of Land Management or by a decree of a Court of Law and /or that the corner points mentioned in lines 3, 4 and 5 above were in conformance with the rules of the Michigan Board of Land Surveyors or by a Decree of a Court of Law; established, re-established, monumented, recovered, found as expressed below:

NOTE: Not more than 2 corners, all in the same town and range, may be recorded on this certificate.

Grid table with columns A-L and rows 1-13. A dot is marked at the intersection of column G and row 6.

A. Description of original monument and accessories and/or subsequent restoration:

G-6: 1/4 Cor. Common to Secs. 15 & 16, T29N-R8W, Helena Township

- 10-1850, GLO Resurvey, L.S. Scranton (Deputy Surveyor), set Elm post, Elm 16", S46°E, 15 Lks (9.90'); Sugar 42", N58°W, 45 Lks (29.7')
5-1888, F.S. Church (Co. Surveyor) found stake and stump of Elm 12", S46°E, 15 Lks (9.9'); Sugar 42", N56°W, 45 Lks (29.7')
1972, LCRC, C.E. Ostling, recorded in Liber 1, Pg. 100, found 1/2" iron, power pole, N89°E, 55.75'; Elm 30", S54°E, 45.20'; Elm 6", N87°W, 50.75'
1979;1983; 1997, Survey by A. Lennox (Co. Surveyor), rec. in Liber 247, Pg. 488, utility pole, N89°E, 55.75'; Elm 30", S54°E, 45.20'; Elm 6", N87°W, 50.75'
1984; 1996, Survey by B. Jones, (1984-recorded in Liber 288, Pg. 199; 1996-recorded in Liber 448, Pg. 1175), found 1/2" iron, power pole East 55.75', Elm 30", S54°E, 45.20'; Elm 6", N27°W, 50.75'
12-1998, Survey by A. Lennox (Co. Surveyor), visited corner, no accessories

B. Description of corner evidence found and/or method applied in restoring or reestablishing corner:

G-6: 1/4 Cor. Common to Secs. 15 & 16, T29N-R8W, Helena Township

- Found 1/2" rerod in CL of N-S asphalt rd, 3' N of old down fence line to E & on old fence line to W; 33' W of E row fence & 40.5' E of W row fence
Fd nail in North side power pole, S84°E, 56.11' (R. 55.75')
Fd nail in West side power pole, S84°E, 55.60' (R. 55.60')
Fd nail in West face power pole, S84°E, 55.77' (R. 55.75')
Set nail in W. Side, Twin 5" Elm, S32°W, 88.85'
Set nail in NE side, 9" Spruce, N29°W, 69.41'
Set PK nail in centerline top North end 15" CMP, N51°E, 39.57'
No G.L.O. witnesses were found.

C. Description of monument for corner and accessories established to perpetuate locating the position of the corner:


G-6: 1/4 Cor. Common to Secs. 15 & 16, T29N-R8W, Helena Township

- Found 1/2" rerod in CL of N-S asphalt rd, 3' N of old down fence line to E & on old fence line to W; 33' W of E row fence & 40.5' E of W row fence
Pulled & replaced with Antrim County monument (Berntsten Model G-1 (30" Piston) with G-2 Cap) and monument box.
Fd nail in North side power pole, S84°E, 56.11' (R. 55.75')
Fd nail in West side power pole, S84°E, 55.60' (R. 55.60')
Fd nail in West face power pole, S84°E, 55.77' (R. 55.75')
Antrim County Peer Group accepted the above monument as the best available evidence of the position of the original corner.

Ratified by Peer Group In accordance with P.O. 345

Antrim Co. Chairman

Signature of Arthur L. Lennox, Nov. 10, 1999

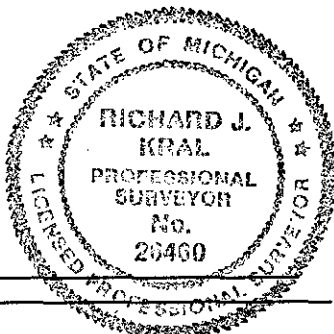

Signed by Richard J. Kral

Michigan License No. 26460

Date 12-9-99

Surveyor's