

JAN 27 2000

LAND CORNER RECORDATION CERTIFICATE  
Filing Requirement of Act 74, Mich. P.A. 1970

Liber 00003 Page 0093

For corners in SECTION

ANTRIM (County)

Located In:

Corner Code #

- 1. Public Land Survey T 29NR 8W G-7  
T R  
T R  
T R
- 2. Property Controlling in Section S T R
- 3. Miscellaneous S T R
- Property in Sec. S T R

ANTRIM COUNTY MI.  
Register of Deeds  
Recorded

12-20-1999 10:11:28


Manda R. Conway  
REGISTER OF DEEDS

Register of Deeds Stamp & File Number

- 4. Lot No. , Recorded Plat
- 5. Private Claims

I, NEIL L. WAY, in a field survey on 12-15, 1999 do hereby state that under requirements of P.A. 74, Michigan P.A. of 1970, the corner points mentioned in lines 1 and 2 above were in conformance with regulations and rules therefore as required in the current manual of survey instructions of the United States Department of the Interior, Bureau of Land Management or by a decree of a Court of Law and for that the corner points mentioned in lines 3, 4 and 5 above were in conformance with the rules of the Michigan Board of Land Surveyors or by a Decree of a Court of Law; established, re-established, nonumented, recovered, found as expressed below:

NOTE: Not more than 2 corners, all in the same town and range, may be recorded on this certificate.

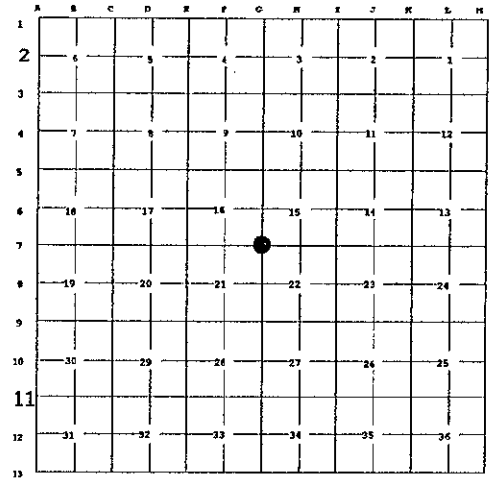

A. Description of original monument and accessories and/or subsequent restoration:

G-7 GLO SET POST 1850, BEECH 18 N1W 53, BEECH 14 S50E 2 CHURCH FOUND GOVT STK AND WIT'S MAY 1888 AND SUB SEC., OSTLING FOUND COR LCR 7-25-72 LIB 1 PG 65. NO WIT'S. LENNOX 8-14-78 FOUND AND WIT 1 1/4" IRON PIPE. LIB 239 PG 14. JONES 7-16-84 FOUND 1 1/4" IRON PIPE AND WIT'S AGREE WITH ABOVE.

3. Description of corner evidence found and/or method applied in restoring or reestablishing corner:

G-7 FOUND 1 1/4" IRON PIPE AND WIT'S AT FENCE CORNER INTERSECTION. WIT'S AGREE WITH ABOVE.. OLD FENCE RUNS N,S,E. ACCEPTED AS CORNER.

2. Description of monument for corner and accessories established to perpetuate locating the position of the corner:

G-7 REMOVED 1 1/4" IRON PIPE AND REPLACED WITH COUNTY MONUMENT.

- S25W 25.40' OAK 14"
- S25E 16.60' OAK 10"
- N62E 23.10' OAK 8"
- N40W 18.30' MPL 8"

Ratified by Peer Group  
In accordance with  
P.O. 345  
Antrim Co. Chairman

Arthur L. Lennox  
Nov. 10, 1999



Signed by Neil L. Way

Date DEC 15, 1999

Surveyor's Michigan License No. 28432