

JAN 27 2000

Liber 00003 Page 0098

SECTION

LAND CORNER RECORDATION CERTIFICATE
Filing Requirement of Act 74, Mich. P.A. 1970

For corners in

ANTRIM (County)

HELENA TOWNSHIP
Located in:

Corner Code #

1999 REMONUMENTATION
1. Public Land Survey

Table with columns for Township/Range (T. 29N R. 8W), North/South (T, S), and East/West (R, W) markers.

2. Property Controlling in Section
3. Miscellaneous Property in Sec.

ANTRIM COUNTY MI.
Register of Deeds
Recorded

01-04-2000 09:53:49

Wanda R. Conway
REGISTER OF DEEDS

Register of Deeds Stamp & File Number

4. Lot No. , Recorded Plat

5. Private Claims

I, RICHARD J. KRAL, in a field survey on November 17, 1999 do hereby state that under requirements of P.A. 74, Michigan P.A. of 1970, the corner points mentioned in lines 1 and 2 above were in conformance with regulations and rules therefore as required in the current manual of survey instructions of the United States Department of the Interior, Bureau of Land Management or by a decree of a Court of Law and for that the corner points mentioned in lines 3, 4 and 5 above were in conformance with the rules of the Michigan Board of Land Surveyors or by a Decree of a Court of Law; established, re-established, monumented, recovered, found as expressed below:

NOTE: Not more than 2 corners, all in the same town and range, may be recorded on this certificate.

Grid table with columns A-L and rows 1-13, showing section numbers and a central marker at T29N R8W S15.

A. Description of original monument and accessories and/or subsequent restoration:

- H-5: 1/4 Cor. Common to Secs. 10 & 15, T29N-R8W, Helena Township
10-1850, GLO Resurvey by L.S. Scranton (Deputy Surveyor) set post, Sugar 16", S11°E, 32 Lks (21.12'); Sugar 10" N32°W, 34 Lks. (22.44')
5-1888, Survey by F.S. Church (Co. Surveyor), found 1/4 post, Sugar 16", S12°E, 32 Lks (21.12'); stump of Sugar 10", N33°W, 33 Lks.; marked Sugar N29°E, 19 1/2 Lks (12.87')
1890, Chicago and North Michigan Railroad Map, no ties, no accessories
8-1998, Survey by N. Way, set 1/2" iron rod and a cap #28432 at single proration to GLO, no drawing or accessories

B. Description of corner evidence found and/or method applied in restoring or reestablishing corner:

- H-5: 1/4 Cor. Common to Secs. 10 & 15, T29N-R8W, Helena Township
Found iron & cap #28432, 5' North of CL of gravel E-W rd; 1' East of old fence line to N & S; 20' S of N row fence corner; 39' N of S row fence cor.
Fd iron & cap #28432, S07°W, 33.14'
Reestablished 1/4 corner per pro-rated angle and distance to F.S. Church 1888 Survey falls on North-South fence lines in Sec. 15. Set Antrim County monument (Berntsten Model G-1 (30" Piston) with G-2 Cap) S89°42'00"E, PR. 2646.51'; S89°52'00"E, PR. 2646.07'
S33°E, 43.76', 5" Elm, nail in SW side
S63°E, 57.25', 3" Maple, nail in SE side
N31°W, 36.51', 5" Apple, nail in NE side
N60°E, 62.18'; 3" Cherry, nail in NW side
North, 24.1', old down corner fence post
South, 35.1', old corner fence post
No G.L.O. witnesses were found.


Ratified by Peer Group
In accordance with
P.O. 345
Antrim Co. Chairman

Arthur L. Lennox
Nov. 10, 1999

C. Description of monument for corner and accessories established to perpetuate locating the position of the corner:

- H-5: 1/4 Cor. Common to Secs. 10 & 15, T29N-R8W, Helena Township
Found iron & cap #28432, 5' North of CL of gravel E-W rd; 1' East of old fence line to N & S; 20' S of N row fence corner; 39' N of S row fence cor.
Fd iron & cap #28432, S07°W, 33.14'
Reestablished 1/4 corner per pro-rated angle and distance to F.S. Church 1888 Survey falls on North-South fence lines in Sec. 15. Set Antrim County monument (Berntsten Model G-1 (30" Piston) with G-2 Cap) S89°42'00"E, PR. 2646.51'; S89°52'00"E, PR. 2646.07'
S33°E, 43.76', 5" Elm, nail in SW side
S63°E, 57.25', 3" Maple, nail in SE side
N31°W, 36.51', 5" Apple, nail in NE side
N60°E, 62.18'; 3" Cherry, nail in NW side
North, 24.1', old down corner fence post
South, 35.1', old corner fence post
Antrim County Peer Group accepted the above monument as a careful and faithful reestablishment of the position of the original corner.

Signed by Richard J. Kral
Michigan License No. 26460

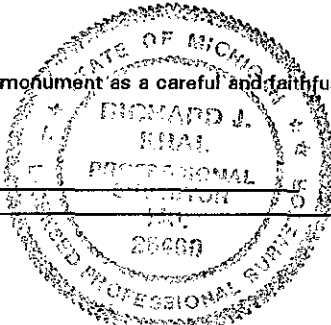

Date 12-9-99 Surveyor's