

JAN 27 2000

LAND CORNER RECORDATION CERTIFICATE Liber 00003 Page 0092
Filing Requirement of Act 74, Mich. P.A. 1970

For corners in

<u>ANTRIM SECTION</u> (County)	Located In:	Corner Code #
1. Public Land Survey	T <u>29</u> N <u>R</u> <u>8</u> W	<u>H-7</u>
	T___R___	_____
	T___R___	_____
	T___R___	_____
2. Property Controlling in Section	S___T___R___	_____
	S___T___R___	_____
3. Miscellaneous Property in Sec.	S___T___R___	_____
	S___T___R___	_____

ANTRIM COUNTY MI.
Register of Deeds
Recorded

12-20-1999 10:11:16


Manda R. Conway
REGISTER OF DEEDS

Register of Deeds Stamp & File Number

4. Lot No. _____, Recorded Plat _____
5. Private Claims _____

I, NEIL L. WAY, in a field survey on 12-15, 1999 do hereby state that under requirements of P.A. 74, Michigan P.A. of 1970, the corner points mentioned in lines 1 and 2 above were in conformance with regulations and rules therefore as required in the current manual of survey instructions of the United States Department of the Interior, Bureau of Land Management or by a decree of a Court of Law and /or that the corner points mentioned in lines 3, 4 and 5 above were in conformance with the rules of the Michigan Board of Land Surveyors or by a Decree of a Court of Law, established, re-established, monumented, recovered, found as expressed below:

NOTE: Not more than 2 corners, all in the same town and range, may be recorded on this certificate.

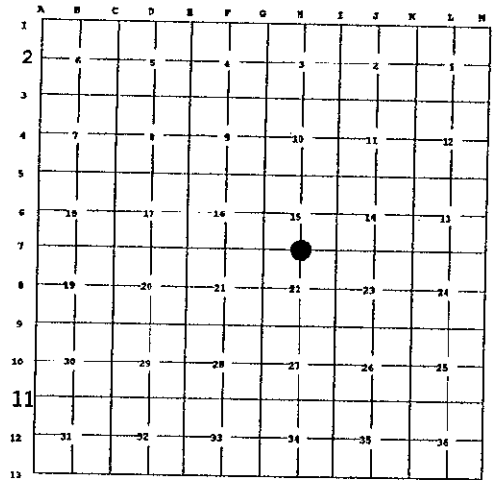

A. Description of original monument and accessories and/or subsequent restoration:

H-7 GLO SET POST 1850, BIRCH 14 S64E 40, SUGAR 20 N73W 16.

CHURCH FOUND GOV'T STK AND WIT'S MAY 1888, MARKED A HEMLOCK N 1 1/2 E 26.
HE SUBDIV. SEC 22.

3. Description of corner evidence found and/or method applied in restoring or reestablishing corner:

H-7 FOUND NO CORNER EVIDENCE AT SITE OTHER THAN CENTERLINE OF E-W ROAD AND OLD FENCE TO NORTH AND SOUTH.

SET PK NAIL AT CENTERLINE OF ROAD A SINGLE PROP. MEAS. FROM CHURCH SURVEY. CORNER FALLS ON OLD FENC LINE TO NORTH AND SOUTH.


Ratified by Peer Group
In accordance with
P.O. 345
Antrim Co. Chairman

Arthur L. Lennox
Nov. 10, 1999

2. Description of monument for corner and accessories established to perpetuate locating the position of the corner:

H-7 REMOVED PK NAIL AND SET COUNTY MONUMENT AND MONUMENT BOX.

S10W 30.57' GUY POLE
S8E 83.35' POST
N15W 39.70' P.POLE
NORTH 110.10' STUMP 24"

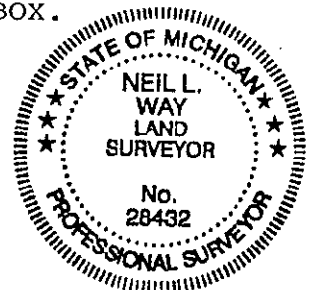

Signed by Neil L. Way

Date DEC 15, 1999

Surveyor's Michigan License No. 28432